

**SURVEY &
REMONUMENTATION**

APR 25 1995

COMMISSION

1994 REMONUMENTATION PROGRAM

**LAND CORNER RECORDATION CERTIFICATE
Filing Requirement of Act 74, Mich. P.A. 1970**

For corners in Arbela Township

<u>Tuscola</u> (County)	Located In:	Corner Code ##
1. Public Land Survey	T <u>10N</u> R <u>7E</u>	<u>M-9</u>
	T _____ R _____	_____
	T _____ R _____	_____
	T _____ R _____	_____
2. Property Controlling in Section	S _____ T _____ R _____	_____
	S _____ T _____ R _____	_____
3. Miscellaneous Property in Sec.	S _____ T _____ R _____	_____
	S _____ T _____ R _____	_____

4. Lot No. _____, Recorded Plat _____
5. Private Claims _____

I, Kenneth D. Dunton in a field survey on August 6, 19 94, do hereby certify that under requirements of P.A. 74, Michigan P.A. of 1970, the corner points mentioned in lines 1 and 2 above were in conformance with regulations and rules therefore as required in the current manual of survey instructions of the United States Department of the Interior, Bureau of Land Management or by a decree of a Court of Law and/or that the corner points mentioned in lines 3, 4 and 5 above were in conformance with the rules of the Michigan Board of Land Surveyors or by a Decree of a Court of Law; established, re-established, monumented, re-monumented, recovered, found as expressed below:

NOTE: Not more than 4 corners, all in the same town and range, may be recorded on this certificate.

A. Description of original monument and accessories and/or subsequent restoration:

1821 G. L. O. Notes	Oct. 28, 1886	Sept. 18, 1972 Survey by D. T. Rowe, L. S. #11192, recorded in Liber 2 of Surveys on Pages 109 & 1 Tuscola County records.
Joseph Wampler, D. S.	John A. Teskey, Surveyor	Found 5/8" rod.
Set post corner	No mention of object	N60°W 71.54' nail in 24" maple
Sections 24 & 25.	found or set. No	N40°E 58.17' nail in t.p.
Beech 38 S28W 17	accessories given.	North 4.75' centerline of pavement.
Beech 16 N 1 1/2 E 24		

Section A continued on back of this form.

B. Description of corner evidence found and/or method applied in restoring or reestablishing corner:

Found 3/4" iron rod in monument box. Accepted 3/4" iron rod as the proper position of the original corner.

C. Description of monument for corner and accessories established to perpetuate locating the position of the corner:

Placed 12" x 5/8" iron rod with standard brass cap stamped corner M-9, T10N-R7E, over 3/4" iron rod found. Encased rod & brass cap in concrete in monument box.
S58°54'W 62.94' found #11192 tag & nail in NE face t. pole stub.
N64°36'W 72.2' center of 24" stump.
N44°54'W 47.05' found "T" iron.
N23°15'E 131.74' found conc. mon. at SW corner plat of "Iva's Acres".
N23°39'E 134.23' found spike in SW face p. pole.
N01°46'40"E 71.13' found 1" pipe in mon. box at apparent cor. A-9, T10N-R8E


COPY

RECEIVED FOR RECORD
LIBER NO. _____ PAGE NO. _____
FILING NO. # 100
ARBELA TWP.
94 DEC - 1 PM 4: 26
VIRGINIA H. MCLAREN
TUSCOLA COUNTY
REGISTER OF DEEDS

Register of Deeds Stamp & File Number

	A	B	C	D	E	F	G	H	I	J	K	L
2	6		5		4		3		2			
3												
4	7		8		9		10		11			
5												
6	18		17		16		15		14			1
7												
8	19		20		21		22		23			2
9												
10	30		29		28		27		26			2
11												
12	31		32		33		34		35			3
13												

Signed by [Signature] Date November 7, 1994
Surveyor's Michigan License No. 23503
APPROVED
11-7-94
FORM APPROVED BY MICHIGAN STATE BOARD OF LAND SURVEYORS, JAN. 28, 1977
REVISED MAY 14, 1977

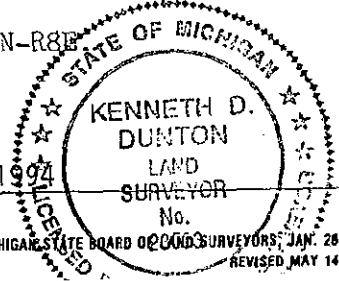

Section A continued:

August 23 & October 1, 1972 Land corner recordation form, filed on Page 22, Arbela Township, by D. T. Rowe, L. S. #11192. Found 5/8" rod.
N60°W 71.54' nail in 24" maple.
S60°W 62.82' R.L.S. #11192 tag in t. pole.
N40°E 58.19' nail in t. pole.

August 23, 1972 Witness card by K. D. Dunton with Rowe Engineering. Found 5/8" rod.
N60°W 71.54' nail in 24" maple.
S60°W 62.82' Rowe Eng. R.L.S. tag in t.p.
N40°E 58.19' nail in t.p.
North 4.75' centerline pave.
North 71.01' pipe @ SW cor. Sec. 19 Millington Twp.
Note: Information verified 12-26-78 by W. F. Clink.

