
## SURVEYS REMONUMENTATION

MAY 0 5 1997

## 1996 REMONUMENTATION PROGRAM LAND CORNER RECORDATION CERTIFICATE

MAY 0 5 1997		ER RECORDATION CERTI ment of Act 74, Mich. P.,			•	D.	96	LIBER FILE F	ניו ניו
For corners in ARBEMANSION  TUSCOLA Locate (County)	ed In: .	Corner Code #			108001 108001	7. 7. 7.	DEC 2	R HO.	CELAED
Τ <u>.</u> Τ <u>.<b>/</b>Ο</u> ί	V R 07E R V R 08E	M-13 A-/3:			A COUNTY		6 WHII: 50	bela 164	Fon Recorp
Property Controlling ST in Section ST      Miscellaneous ST	R R R		Registe	r of De	eds S	tamp 8	k File N	lumbe	r 
Property in Sec. ST								<u>-</u>	
5. Private Claims			<del></del> '	A B (	C D	F G	H 1	JK	L M
	•		3	6	5	4	3	2	1
t. <u>JONATHAN M. FIELD</u> , in a fi do hereby certify that under requirements of P	eld survey on OC'	TOBER 19 S	3 , 4	7	8	9	10	11	12
in lines 1 and 2 above were in conformance current manual of survey instructions of the U.	with regulations a nited States Depar	and rules therefore as required timent of the Interior Bureau of	in the	18	17	16	15	14	13
Management or by a decree of a Court of Law above were in conformance with the rules of Court of Law; established re-established	and/or that the cor the Michigan Board	ner points mentioned in lines 3, 4 i of Land Surveyors or by a Decr	and 5 7	19	20	21	22	23	24
expressed below;			10	30	29	28	27	26	25
NOTE: Not more than 4 corners, all in to this certificate.	ne same town a	nd range, may be recorded	11 12 13	31	32	33	34	35	36
1976 BECK, P.S.#21559; LCRC 46.91' TAG #11192 T.PO! 1983 TUSCOLA CO. RD. COMM.; NO WITS GIVEN 1988 DUNTON LAND SURVEY.; DE WITS GIVEN 1989 SZYSZKOSKI, P.S.#33986 W/FLAG. 30" BOXELDER, 1	LE, N70W 96.  DUNTON, P.S.  UNTON, P.S.#	22' NAIL W/DISC 30" .#23503; FIELD NOTES 23503; FIELD NOTES ; FND 5/8" ROD; N451	MAPLE OF JOB NO E 42.40	NO. I . 822 RD S1	JR-54 2-87;	37; F FND	'ND 5,	/8" R ROD;	ио
CUT-OFF T.POLE  B. Description of corner evidence fou  1993 ROWE ENG.; FIELD, P.S.;  ROADS N-S-E-W 2 PREVIOU  CITED ABOVE	nd and/or metho #37276; FND.	d applied in restoring or rees	tablishing co	mer:	ERSE	CTION	OFG	RAV.	
ACCEPTED 5/8" ROD AS BE	EST EVIDENCE	OF ORIGINAL CORNER	LOCATION						λ·
C. Description of monument for corne M-13 REMOVED ROD, SET STANDA N38°W, 45.88° FND 40D N74°W, 95.98° SET NAIL S42°W, 49.07° ROAD SIG S26°E, 81.91° SET NAIL N45°E, 46.75° FND P-K #11192 A	ARD REMON MO NAIL W/TAG: W/REMON TAG N POST W/REMON TAG NAIL W/TAG (	NUMENT, CAP STAMPED #20709 IN SE ROOT 30 G IN SE ROOT 28° MAP	"A 13 T1( " BOXELDE LE ISC IN SW T-OFF T.P	ON REER	EP.P	OLE		L W/1	FAG
N45°E, 42.40' ROAD SIG N45°W, 123.44' SE COR.  This corner is common to the monument and accessors  Signed by Author To To	N POST NEW CONC. BI With A-13 TI ES SET 10-29	COCK BASEMENT UNDER ON-R8E	older hou 23-9	76	- 1		JONATI M. FIE ROFESS SURVE	LD SIONAL YOR	DAVETOR
Surveyo('• Michigan License No. <u>37276</u>	~- <del></del> -	-11-96 RE	FORM APPROVED BY	MICHIGA?		o FOR WO	O P TEV	CHE ONE	18 275 17575 17, 1993

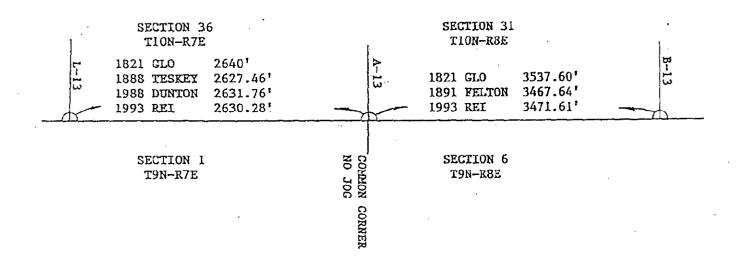



4.