

1333

COMMISSION

1993 REMONUMENTATION PROGRAM
LAND CORNER RECORDATION CERTIFICATE

Filing Requirement of Act 74, Mich. P.A. 1970

MILLINGTON TOWNSHIP

For corners in
TUSCOLA
(County)

Located In:

Corner Code #

1. Public Land Survey	T	10	N	R	8	E	H-13
	T		R				
	T		R				
	T		R				
2. Property Controlling in Section	S		T		R		
	S		T		R		
3. Miscellaneous Property in Sec.	S		T		R		
	S		T		R		

RECEIVED FOR RECORD
LIBER NO. PAGE NO. 17
FILING NO. Millington
93 NOV 19 PM 1:25
VIRGINIA M. HALL
TUSCOLA COUNTY
REGISTER OF DEEDS

Register of Deeds Stamp & File Number

- 4. Lot No. _____, Recorded Plat _____
- 5. Private Claims _____

	A	B	C	D	E	F	G	H	I	J	K	L	M
1													
2	6	5	4	3	2	1							
3													
4	7	8	9	10	11	12							
5													
6	18	17	16	15	14	13							
7													
8	19	20	21	22	23	24							
9													
10	30	29	28	27	26	25							
11													
12	31	32	33	34	35	36							
13													

I, JONATHAN M. FIELD, in a field survey on OCTOBER 19 93, do hereby certify that under requirements of P.A. 74, Michigan P.A. of 1970, the corner points mentioned in lines 1 and 2 above were in conformance with regulations and rules therefore as required in the current manual of survey instructions of the United States Department of the Interior, Bureau of Land Management or by a decree of a Court of Law and/or that the corner points mentioned in lines 3, 4 and 5 above were in conformance with the rules of the Michigan Board of Land Surveyors or by a Decree of a Court of Law; established, re-established, monumented, re-monumented, recovered, found as expressed below:

NOTE: Not more than 4 corners, all in the same town and range, may be recorded on this certificate.

A. Description of original monument and accessories and/or subsequent restoration:

- 1821 GLO - WAMPLER, D.S.; SET 1/2 MILE POST; MAPLE 16" S28W 17 1/2LKS., BEECH 11" N59W 29LKS.
- 1971 ROWE ENG. - ROWE, P.S.#11192; SURVEY L.1, PG.43 - FND 1" BAR & POTTERY 24" DEEP, SET T-IRON; S55W 51.87' NAIL W/CAP 18" TREE, S60W 67.29' NAIL W/CAP 24" TREE, N70W 115.87' NAIL W/CAP T.POLE, N60E 37.01' N. END 18" CMP, N55E 37.55' S. END 18" CMP
- 1972 ROWE, P.S.#11192; LCRC PG.12 (FIELD DATE 5-6-71) - FND 1" BAR 2' BELOW SURFACE, RAISED W/ T-IRON; SAME WITS AS 1971 REI SURVEY
- 1978 KAY ENG. - GETZ, P.S.#25843; UNRECORDED SURVEY PROJ. NO. 78-252 - FND T-IRON; WITS SAME AS 1971 REI SURVEY

B. Description of corner evidence found and/or method applied in restoring or reestablishing corner:

- 1993 ROWE ENG. - FIELD, P.S.#37276; FND T-IRON; 4'N. TO INTERSECTION OF GRAV. ROAD E-W & FENCE LINE TO N. FND NO OTHER EVIDENCE


ACCEPTED T-IRON AS BEST EVIDENCE OF ORIGINAL CORNER LOCATION

COPY

SEE ALSO BACK OF THIS FORM

C. Description of monument for corner and accessories established to perpetuate locating the position of the corner:

- H-13 REMOVED T-IRON, SET STANDARD MONUMENT (5/8" X 36" ROD W/ BRASS CAP IN CONC)
- NORTH, 32.92' FND 1/2" ROD W/CAP #23510
- N29°W, 64.61' SET NAIL W/REMON TAG IN SW FACE P.POLE
- S59°E, 31.71' SET PUNCH HOLE IN TOP CENTER S. END 18" CSP
- N50°E, 36.60' SET PUNCH HOLE IN TOP CENTER N. END 18" CSP
- S51°W, 51.99' SET NAIL W/REMON TAG IN N. ROOT 20" MAPLE
- S62°W, 67.14' SET NAIL W/REMON TAG IN N. ROOT 24" MAPLE
- WEST, 214.45' FND BENT 60D NAIL, REPLACED W/ 1/2" ROD

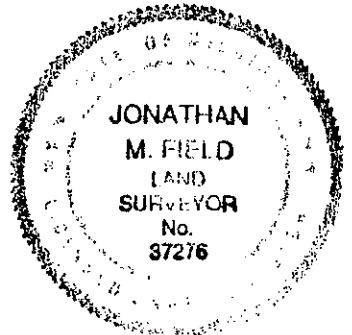


Signed by Jonathan M Field Date 10-27-93
Surveyor's Michigan License No. 37276

APPROVED
10-25-93
J.M.F.

COPY



SECTION 34
T10N-R8E

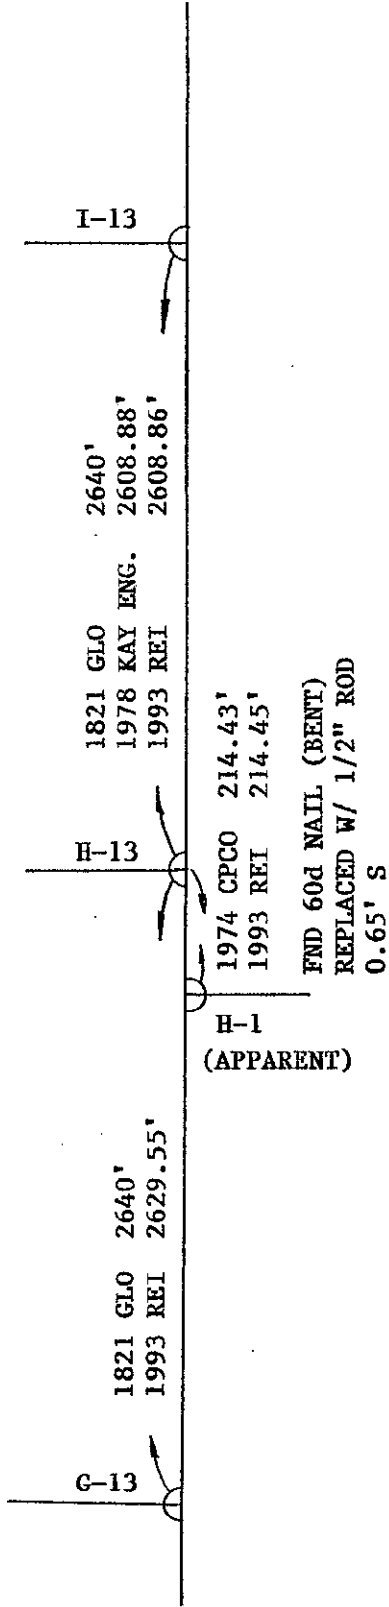

SECTION 3
T9N-R8E