

833

1993 REMONUMENTATION PROGRAM  
LAND CORNER RECORDATION CERTIFICATE

COUNTY

Filing Requirement of Act 74, Mich. P.A. 1970

For corners in TUSCOLA (County) Located in: MILLINGTON TOWNSHIP Corner Code # \_\_\_\_\_

1. Public Land Survey	T 10 N R 8 E	I-13
	T R	
	T R	
	T R	
2. Property Controlling in Section	S T R	
	S T R	
3. Miscellaneous Property in Sec.	S T R	
	S T R	

RECEIVED FOR RECORD  
LIBER NO. \_\_\_\_\_ PAGE NO. 18  
FILING NO. Millington  
93 NOV 19 PM 1:25  
VIRGINIA H. HALLAM  
TUSCOLA COUNTY  
REGISTER OF DEEDS

Register of Deeds Stamp & File Number

4. Lot No. \_\_\_\_\_, Recorded Plat \_\_\_\_\_  
5. Private Claims \_\_\_\_\_

I, JONATHAN M. FIELD, in a field survey on OCTOBER 19 93, do hereby certify that under requirements of P.A. 74, Michigan P.A. of 1970, the corner points mentioned in lines 1 and 2 above were in conformance with regulations and rules therefore as required in the current manual of survey instructions of the United States Department of the Interior, Bureau of Land Management or by a decree of a Court of Law and/or that the corner points mentioned in lines 3, 4 and 5 above were in conformance with the rules of the Michigan Board of Land Surveyors or by a Decree of a Court of Law; established, re-established, monumented, re-monumented, recovered, found as expressed below:

NOTE: Not more than 4 corners, all in the same town and range, may be recorded on this certificate.

1	A	B	C	D	E	F	G	H	I	J	K	L	M
2		6	5	4	3	2	1						
3													
4		7	8	9	10	11	12						
5													
6		18	17	16	15	14	13						
7													
8		19	20	21	22	23	24						
9													
10		30	29	28	27	26	25						
11													
12		31	32	33	34	35	36						
13													

A. Description of original monument and accessories and/or subsequent restoration:

- 1821 GLO - WAMPLER, D.S.; SET POST; BEECH 10" S50W 20LKS., BEECH 8" N45E 27LKS.
- 1972 ROWE, P.S.#11192; LCRC PG.12 (FIELD DATE 5-6-71) - FND 3/8" ROD; N20W 60.38' NAIL W/CAP P.POLE, N55E 87.49' NAIL W/CAP P.POLE, N35E 45.7' RD SIGN POST
- 1974 CPCO - MCCOMBS, P.S.#10696; SURVEY OF SEC.3,T9N-R8E - NO OBJECT STATED; NO WITS GIVEN; DIST OF 198.0' SHOWN TO I-1,T9N-R8E
- 1976 AMERICAN CIVIL ENG.- PIOTROWSKI, P.S.#9685; SURVEY L.511, PG.166-168 - FND 1/2" ROD; WITS SAME AS 1972 ROWE LCRC
- 1977 MILLER, P.S.#12024; LCRC PG.47 - FND 1/2" ROD; WITS SAME AS 1972 ROWE LCRC
- 1978 KAY ENG.- GETZ, P.S.#25843; UNRECORDED SURVEY PROJ. NO. 78-252 - FND 1/2" ROD; N20W 59.80' P.POLE, N55E 87.49' P.POLE, N35W 37.80' ROAD SIGN

B. Description of corner evidence found and/or method applied in restoring or reestablishing corner:

1993 ROWE ENG. - FIELD, P.S. #37276; FND 1/2" ROD; 2'N & 4'E TO INTERSECTION OF GRAV. ROADS N-E-W  
FND NO OTHER EVIDENCE


ACCEPTED 1/2" ROD AS BEST EVIDENCE OF ORIGINAL CORNER LOCATION

COPY

SEE ALSO BACK OF THIS FORM

C. Description of monument for corner and accessories established to perpetuate locating the position of the corner:


- I-13 REMOVED 1/2" ROD, SET STANDARD MONUMENT (5/8" X 36" ROD W/ BRASS CAP IN CONC)
- N51°E, 87.73' SET NAIL W/REMON TAG IN SE FACE P.POLE (ALSO FND NAIL W/BOTTLE CAP IN SW FACE)
- N19°W, 59.82' SET NAIL W/REMON TAG IN NE FACE P.POLE (ALSO FND NAIL W/FLAG. NE FACE.)
- N57°W, 55.04' SET NAIL W/REMON TAG IN S. FACE 12" RED PINE
- N48°E, 50.46' SET NAIL W/REMON TAG IN SE FACE CUT-OFF T.POLE
- S08°W, 12.11' ROAD SIGN POST
- S16°E, 11.84' E. EDGE OF E POST OF DIRECTIONAL SIGN
- WEST, 197.84' FND 1/2" ROD W/CAP #10696

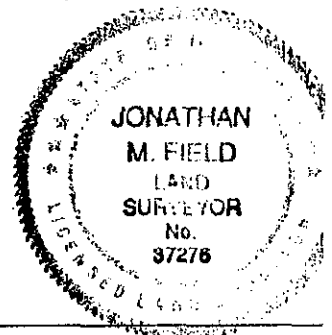

Signed by Jonathan M. Field Date 10-27-93

Surveyor's Michigan License No. 37276

APPROVED  
10-25-93  
*J.M.F.*

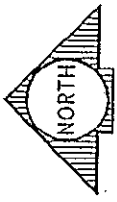

COPY

SECTION 34  
T10N-R8E

SECTION 35  
T10N-R8E

