

**SURVEY & REMONUMENTATION**

**FEB 08 2001**

**SECTION**

**2000 REMONUMENTATION  
LAND CORNER RECORDATION CERTIFICATE  
Filing Requirement of Act 74, Mich. P.A. 1970**

RECEIVED FOR RECORD  
LIBER NO. \_\_\_\_\_ PAGE NO. \_\_\_\_\_  
FILE NO. **#99 Millington**  
**00 DEC 20 PM 2:41**

*Jonathan M. Field*  
TUSCOLA COUNTY  
REGISTER OF DEEDS

For corners in: **MILLINGTON TWP.**

<u>TUSCOLA</u> (County)	Located In:	Corner Code #
1. Public Land Survey	T <u>10N</u> R <u>08E</u>	<u>K-1</u>
	T _____ R _____	_____
	T _____ R _____	_____
	T _____ R _____	_____
2. Property Controlling in Section	S _____ T _____ R _____	_____
	S _____ T _____ R _____	_____
3. Miscellaneous Property in Sec.	S _____ T _____ R _____	_____
	S _____ T _____ R _____	_____

Register of Deeds Stamp & File Number

4. Lot No. \_\_\_\_\_, Recorded Plat \_\_\_\_\_  
5. Private Claims \_\_\_\_\_

I, JONATHAN M. FIELD, in a field survey on AUGUST 17 2000, do hereby certify that under requirements of P.A. 74, Michigan P.A. of 1970, the corner points mentioned in lines 1 and 2 above were in conformance with regulations and rules therefore as required in the current manual of survey instructions of the United States Department of the Interior, Bureau of Land Management or by a decree of a Court of Law and/or that the corner points mentioned in lines 3, 4 and 5 above were in conformance with the rules of the Michigan Board of Land Surveyors or by a Decree of a Court of Law; established, re-established, monumented, re-monumented, recovered, found as expressed below:


**NOTE: Not more than 4 corners, all in the same town and range, may be recorded on this certificate.**

A. Description of original monument and accessories and/or subsequent restoration:  
1822 GLO; FLETCHER, D.S.; SET POST; BEECH 12 S28°W 7 LKS., HEMLOCK 16 S60°E 21 LKS.  
1896 TESKEY, C.S.; PG.282-3; POST STONE AND CROCKERY; PINE STUMP 32" S61°W 53 LKS.  
1976 ROWE ENG.; ROWE, P.S. #11192; LCRC, PG.46; 1/2" RE-ROD WITH CAP #11192; N40°W 53.49' DISC #11192 IN POWER POLE; S70°E 99.10' NAIL & WASHER IN TELEPHONE POLE, S45°W 53.08' ROAD SIGN POST; EAST 140.58' SW COR. SEC. 36, VASSAR TWP.  
1976 ROWE ENG.; ROWE, P.S. #11192; SURVEY, L.460 PG.388; SAME OBJECT AND WITS AS 1976 LCRC  
1981 LEACH ENG.; LEACH, P.S. #7236; SURVEY L.513 PG.1385; SAME OBJECT AND WITS AS 1976 LCRC  
1990 SPICER ENG.; PREVOST, P.S. #24612; SURVEY L.606 PGS.1420, 1424; SAME OBJECT AND WITS AS 1976 LCRC  
1990 SPICER ENG.; PREVOST, P.S. #24612; SURVEY L.607 PG.944; SAME OBJECT AND WITS AS 1976 LCRC  
1998 GRAVLIN, P.S.#23510; UNRECORDED SURVEY JOB NO.980157 DATED 9-14-98; FND. 1/2" ROD; SAME WITS AS 1976 LCRC

B. Description of corner evidence found and/or method applied in restoring or reestablishing corner:  
2000 ROWE; FIELD, P.S.#37276; FND. 1/2" ROD IN MON BOX ON S. LINE OF T11N-R8E, 2' E. OF C/L SHERIDAN RD. TO S. & 2.7' S. OF C/L SWAFFER RD.; RECOVERED 3 PREVIOUS WITS WHICH INDICATE THAT FND. ROD IS IN SAME POSITION AS 1976 LCRC CITED ABOVE.

ACCEPTED FND. ROD IN MON. BOX AS BEST AVAILABLE EVIDENCE OF ORIGINAL CORNER POSITION.

C. Description of monument for corner and accessories established to perpetuate locating the position of the corner:  
K-1 SET W/ 5/8" ROD W/ REMON CAP STAMPED K-1 T10N R8E OVER 1/2" ROD, ENCASED ROD & CAP IN CONC. IN MON BOX  
N40°W 53.50' NAIL W/TAG #11192 IN NE FACE P. POLE  
S45°W 53.25' ROAD SIGN POST (CENTER OF POST)  
N25°E, 62.99' SET NAIL W/REMON TAG IN W. FACE 14" PINE  
S50°E, 30.87' SET 1/2" ROD W/ CAP #37276  
EAST 140.62' FND. REMON MONUMENT AT K-13 T11N-R8E (1822 GLO 140.58')

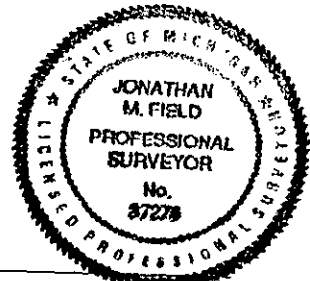

Signed by Jonathan M. Field Date 11-10-2000  
Surveyor's Michigan License No. 37276

APPROVED  
11/8/2000  
KML  
RLB

FORM APPROVED BY MICHIGAN STATE BOARD OF LAND SURVEYORS, JAN. 28, 1971  
REVISED MAY 14, 1978  
REVISED JAN., 1983  
ADAPTED FOR WORD PROCESSING MARCH, 1983

**COPY**

**SURVEY &  
REMONUMENTATION**

FEB 08 2001

SECTION

