

SURVEY & REMONUMENTATION

FEB 08 2001

SECTION

**2000 REMONUMENTATION
LAND CORNER RECORDATION CERTIFICATE
Filing Requirement of Act 74, Mich. P.A. 1970**

RECEIVED FOR RECORD
LIBER NO. _____ PAGE NO. _____
FILE NO. **#103 Millington**
00 DEC 20 PM 2:42

For corners in: **MILLINGTON TWP.**

<u>TUSCOLA</u> (County)	Located In:	Corner Code #
1. Public Land Survey	T <u>10N</u> R <u>08E</u>	K-3
	T _____ R _____	_____
	T _____ R _____	_____
	T _____ R _____	_____
2. Property Controlling in Section	S _____ T _____ R _____	_____
	S _____ T _____ R _____	_____
3. Miscellaneous Property in Sec.	S _____ T _____ R _____	_____
	S _____ T _____ R _____	_____

[Signature]
TUSCOLA COUNTY
REGISTER OF DEEDS

Register of Deeds Stamp & File Number

4. Lot No. _____ Recorded Plat _____
5. Private Claims _____

I, JONATHAN M. FIELD, in a field survey on AUGUST 17, 2000, do hereby certify that under requirements of P.A. 74, Michigan P.A. of 1970, the corner points mentioned in lines 1 and 2 above were in conformance with regulations and rules therefore as required in the current manual of survey instructions of the United States Department of the Interior, Bureau of Land Management or by a decree of a Court of Law and/or that the corner points mentioned in lines 3, 4 and 5 above were in conformance with the rules of the Michigan Board of Land Surveyors or by a Decree of a Court of Law; established, re-established, monumented, re-monumented, recovered, found as expressed below:

	A	B	C	D	E	F	G	H	I	J	K	L	M
1													
2	6	5	4	3	2	1							
3													
4	7	8	9	10	11	12							
5													
6	18	17	16	15	14	13							
7													
8	19	20	21	22	23	24							
9													
10	30	29	28	27	26	25							
11													
12	31	32	33	34	35	36							
13													

NOTE: Not more than 4 corners, all in the same town and range, may be recorded on this certificate.


- A. Description of original monument and accessories and/or subsequent restoration:
 1822 GLO; FLETCHER, D.S.; SET POST; BEECH 12 N30°W 11 LKS., SUGAR 30 S40°E 23 LKS.
 1894 TESKEY, C.S.; PG.238; NO OBJECT STATED; MAPLE 3 N31°W 88 LKS., MAPLE 3 N19 1/2°E 87 LKS.
 1896 TESKEY, C.S.; PG.283; SAME AS 1894 SURVEY
 1975 LEACH ENG.; LEACH, P.S. #7236; LCRC, PG.37; FND. 3/4" RE-ROD IN MON BOX; N40°E 43.45' W FACE T.POLE; S40°E 45.10' STREET SIGN POST; S30°W 93.22' E FACE T.POLE
 1975 LEACH ENG.; LEACH, P.S. #7236; SURVEYS, L.452, PG.583 L.450, PG.589 L.447 PG.902; FND. MON BOX; WITS REFERENCED TO LCRC PG.37
 1975 ROWE ENG.; BECK, P.S. #21559; SURVEY, L.452 PG.610; SAME AS 1975 LCRC
 1975 ROWE, P.S.#11192; LCRC, PG. 44; FND. BOAT SPIKE IN MON BOX; N45°E 42.58' TAG #11192 IN T. POLE, S25°W 92.93' TAG #11192 TAG IN T.POLE, S40°E 44.91' ROAD SIGN POST.
 1977 ROWE ENG.; DUNTON, P.S.#23503; SURVEY, L.482 PG.601; BOAT SPIKE IN MON BOX; N45E 43.71' TAG #11192 IN TELEPHONE POLE, S25°W 92.82' TAG #11192 IN TELEPHONE POLE, S40°E 44.82' ROAD SIGN POST, N46°E 55.52' TAG #11192 IN POWER POLE.
 1983 DUNTON LAND SURVEYING; DUNTON, P.S. #23503; SURVEY L.533 PG.527; IRON IN MON BOX; N40°E 43.8' TAG IN TELEPHONE POLE, S40°E 45.1' SIGN POST, S30°W 93.22' TELEPHONE POLE.
 1985 ROWE ENG.; OWENS, P.S.#20709; SURVEY L.558, PG.711-6; FND. BOAT SPIKE IN MON BOX; SAME WITS AS 1977 SURVEY

(SECTION A. CONTINUED ON BACK)

- B. Description of corner evidence found and/or method applied in restoring or reestablishing corner:
 2000 ROWE; FIELD, P.S.#37276; FND. BOAT SPIKE IN MON BOX; 0.5' E. OF C/L SHERIDAN RD & 2.0' N. OF C/L MURPHY LAKE RD.; RECOVERED 3 PREVIOUS WITS WHICH INDICATE THAT FND. IS IN SAME POSITION AS 1991 SURVEY CITED IN SECTION A.
 BOAT SPIKE BOAT SPIKE

ACCEPTED FND. IN MON. BOX AS BEST AVAILABLE EVIDENCE OF ORIGINAL CORNER POSITION.

- C. Description of monument for corner and accessories established to perpetuate locating the position of the corner:
 K-3 SET 5/8" ROD W/ REMON CAP STAMPED K-3 T10N R8E OVER FND. BOAT SPIKE, ENCASED ROD & CAP IN CONC. IN MON BOX
 S45°E 56.26' TOP CENTER OF PHONE RISER
 N60°E 36.40' S. EDGE STOP SIGN POST
 S55°W 42.33' N. EDGE STOP SIGN POST
 N45°E 48.68 SE COR. OF PHONE RISER
 N45°E 54.48' SET NAIL W/REMON TAG IN SE FACE OF P.POLE
 S45°E, 47.71' FND. 1/2" ROD W/CAP #23510

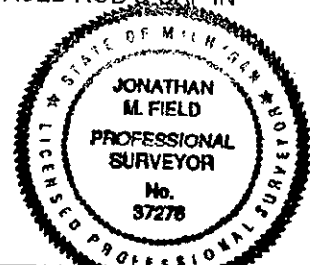

Signed by Jonathan M. Field Date 11-10-2000
 Surveyor's Michigan License No. 37276

APPROVED 11/8/2000
[Signature]
[Signature]

FORM APPROVED BY MICHIGAN STATE BOARD OF LAND SURVEYORS, JAN. 28, 1971
 REVISED MAY 14, 1976
 REVISED JAN., 1983
 ADAPTED FOR WORD PROCESSING MARCH, 1983

COPY

**SURVEY &
REMONUMENTATION**

FEB 08 2001

COPY

SECTION

SECTION A CONT. K-3 T10N-R8E

1991 ROWE ENG.; FIELD, P.S. #37276; SURVEY L.619 PG.1033; FND. BOAT SPIKE IN MON BOX; N40°E 55.64' NAIL AND TAG #11192 SE FACE P. POLE, N60°E 36.40' S EDGE STOP SIGN POST; S45°E 56.26' TOP CTR PHONE RISER, S55°W 42.33' N EDGE STOP SIGN POST.
 1992 ROWE ENG.; FIELD, P.S. #37276; LCRC, PG.69; SAME OBJECT AND WITS AS IN 1991 ROWE.
 1992 GRAVLIN LAND SURVEYING; GRAVLIN, P.S. #23510; SURVEY L.637 PG.766; FND. IRON IN MON BOX; N40°E 55.5' P.POLE, N45°W 49.20 SE COR TELEPHONE PEDESTAL, S40°E 45.10' SIGN POST.
 1998 ROWE ENG.; FIELD, P.S. #37276; SURVEY L.757 PG.200; SAME OBJECT AND WITS AS 1991 ROWE.
 2000 ROWE ENG.; POWELL, P.S. #44298; SURVEY, L.804 PG.16; SAME OBJECT AND WITS AS 1991 ROWE.
 2000 DAVIS LAND SURVEYING; HAY, P.S.#41101; UNRECORDED SURVEY JOB NO.00060 DATED 5/22/00; FND. IRON IN MON BOX; SAME WITS AS 1993 SURVEY ADDED S45°E 47.71' FND. IRON #23510

