

SURVEY & REMONUMENTATION

FEB 08 2001

SECTION

**2000 REMONUMENTATION
LAND CORNER RECORDATION CERTIFICATE
Filing Requirement of Act 74, Mich. P.A. 1970**

RECEIVED FOR RECORD
LIBER NO. _____ PAGE NO. _____
FILE NO. #106 Millington

00 DEC 20 PM 2:42

Gregory M. Johnson
TUSCOLA COUNTY
REGISTER OF DEEDS

For corners in: **MILLINGTON TWP.**

<u>TUSCOLA</u> (County)	Located In:	Corner Code #
1. Public Land Survey	T <u>10N</u> R <u>08E</u>	<u>K-5</u>
	T _____ R _____	_____
	T _____ R _____	_____
	T _____ R _____	_____
2. Property Controlling in Section	S _____ T _____ R _____	_____
	S _____ T _____ R _____	_____
3. Miscellaneous Property in Sec.	S _____ T _____ R _____	_____
	S _____ T _____ R _____	_____
4. Lot No. _____, Recorded Plat _____		
5. Private Claims _____		

Register of Deeds Stamp & File Number

	A	B	C	D	E	F	G	H	I	J	K	L	M
1													
2	6	5	4	3	2	1							
3													
4	7	8	9	10	11	12							
5													
6	18	17	16	15	14	13							
7													
8	19	20	21	22	23	24							
9													
10	30	29	28	27	26	25							
11													
12	31	32	33	34	35	36							
13													

I, JONATHAN M. FIELD, in a field survey on AUGUST 17 2000, do hereby certify that under requirements of P.A. 74, Michigan P.A. of 1970, the corner points mentioned in lines 1 and 2 above were in conformance with regulations and rules therefore as required in the current manual of survey instructions of the United States Department of the Interior, Bureau of Land Management or by a decree of a Court of Law and/or that the corner points mentioned in lines 3, 4 and 5 above were in conformance with the rules of the Michigan Board of Land Surveyors or by a Decree of a Court of Law; established, re-established, monumented, re-monumented, recovered, found as expressed below:

NOTE: Not more than 4 corners, all in the same town and range, may be recorded on this certificate.

A. Description of original monument and accessories and/or subsequent restoration:
 1822 GLO; FLETCHER, D.S.; SET POST: BEECH 10 N31W 14LKS., SUGAR 12 S59E 37LKS.
 1892 FELTON, C.S.; NO OBJECT STATED; SCHOOL HOUSE N63 1/2E 159LKS., PINE (NO SIZE) N43 3/4W 71LKS.
 1894 FELTON, C.S.; NO OBJECT STATED; NO WITS GIVEN
 1971 ROWE ENG.; ROWE, P.S. #11192; SURVEY L.1 PG.152; "T" IRON IN MON BOX; N60°W 63.53' NAIL IN CAP IN TELEPHONE POLE, N70°E 101.45' SW COR OF DWELLING, S45°W 94.79' NAIL AND CAP IN POWER POLE.
 1971 AMERICAN CIVIL ENG.; PIOTROWSKI, P.S. #9685; SURVEY L.1 PG.224; FND. IRON IN MON BOX; N50°W 63.5' T.POLE, S35°W 62.5' T.POLE, N60°E 101.50' SW COR HOUSE.
 1972 MILLER, P.S. #12024; LCRC, PG.1; SAME AS 1971 AMERICAN CIVIL ENG.
 1972 KAY ENG.; KAY, P.S. #14096; SURVEY, L.1 PG. 498; NO OBJECT STATED; SAME WITS AS 1971 ROWE SURVEY
 1972 KAY ENG.; KAY, P.S. #14096; SURVEY, L.2 PG.156-7; NO OBJECT STATED; SAME WITS AS 1971 ROWE SURVEY
 1973 BROWN, P.S. #17613; LCRC PG. 31; 1/2" IRON ROD IN MON BOX; EAST 36.65' NAIL IN 7" HICKORY, WEST 64.58' NAIL IN P.POLE, S80°E 52.03 NAIL IN 24" WILLOW
 1973 KAY ENG.; KAY, P.S. #14096; SURVEY, L.437 PG.277; NO OBJECT STATED; SAME WITS AS 1971 ROWE SURVEY
 1973 KAY ENG.; KAY, P.S. #14096; SURVEY, L.449 PG.528-9; SAME OBJECT AND WITS AS 1971 ROWE SURVEY
 1974 KAY ENG.; KAY, P.S. #14096; SURVEY, L.438 PG.475; SAME OBJECT AND WITS AS 1971 ROWE SURVEY
 1977 BECK-GRAVLIN; BECK, P.S. #21559; SURVEY, L.486 PG.426; "T" IRON IN MON BOX; N60°W 63.6' NAIL AND DISC IN T.POLE, S30°W 62.3' NAIL AND DISC IN T.POLE
 1977 BECK-GRAVLIN; BECK, P.S. #21559; SURVEY, L.496 PG.1490; SAME AS 1977 SURVEY

(SECTION A. CONTINUED ON BACK)


B. Description of corner evidence found and/or method applied in restoring or reestablishing corner:
 2000 ROWE; FIELD, P.S.#37276; FND. 3/4" ROD IN MON. BOX; ON C/L SHERIDAN RD. & 0.5' S. OF C/L MILLINGTON RD.; RECOVERED 1 PREVIOUS WIT WHICH INDICATES THAT FND. ROD IS IN SAME POSITION AS 1971 SURVEYS CITED ABOVE.
 ACCEPTED FND. ROD IN MON. BOX AS BEST AVAILABLE EVIDENCE OF ORIGINAL CORNER POSITION.

C. Description of monument for corner and accessories established to perpetuate locating the position of the corner:
 K-5 SET 5/8" ROD W/ REMON CAP STAMPED K-5 T10N R8E OVER FND. 3/4" ROD, ENCASED ROD & CAP IN CONC. IN MON BOX
 N 39°W 53.64' CENTER OF ROAD SIGN POST
 S41°W 97.03' NAIL W/TAG #37276 NW FACE P.POLE
 N66°E 101.44' SW COR. OF HOUSE FOUNDATION
 N45°E, 46.59' CHIS. NOTCH IN N. END 18" CMP
 S45°E, 33.88' CHIS. NOTCH IN S. END 18" CMP
 N27°E 79' CENTER OF 30" ELM

Signed by *Jonathan M. Field* Date 11-10-2000
 Surveyor's Michigan License No. 37276

FORM APPROVED BY MICHIGAN STATE BOARD OF LAND SURVEYORS, JAN. 24, 1971
 REVISED MAY 14, 1975
 REVISED JAN., 1983
 ADAPTED FOR WORD PROCESSING MARCH, 1983

APPROVED
11/8/2000
KML
RJB

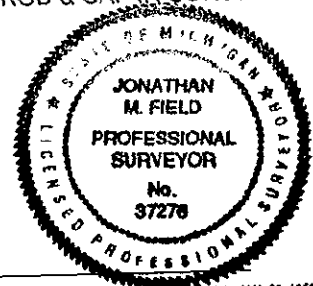

COPY

**SURVEY &
REMONUMENTATION**

FEB 08 2001

COPY

SECTION

SECTION A CONT. K-5 T10N-R8E

1984 GRAVLIN, P.S.#23510; UNRECORDED SURVEY JOB NO.178-84 DATED 6-14-84; SAME AS 1977 SURVEY
 1985 GRAVLIN, P.S. #23510; SURVEY, L.553 PG.66; SAME AS 1977 SURVEY
 1986 ROWE ENG.; OWENS, P.S.#20709; SURVEY L.558 PG.711-6; SAME AS 1971 ROWE SURVEY
 1993 ROWE ENG.; FIELD, P.S. #37276; SURVEY, L.644 PG.323; FND. 3/4" ROD IN MON BOX; N39°W 53.64' CENTER OF ROAD SIGN POST, S41°W 97.03' TAG #37276 NW FACE P.POLE, N66°E 101.44' COR. OF HOUSE FOUND., N27°E 78.69' NAIL W/CAP #37276 W FACE 30" ELM

* PREVIOUS MEASUREMENTS WERE MADE TO IRON AT CENTERLINE PI OF MILLINGTON ROAD SEE 1993 REMON LCRC PG.90

