

**SURVEY & REMONUMENTATION**

FEB 08 2001

**SECTION**

**2000 REMONUMENTATION  
LAND CORNER RECORDATION CERTIFICATE  
Filing Requirement of Act 74, Mich. P.A. 1970**

RECEIVED FOR RECORD  
LIBER NO. \_\_\_\_\_ PAGE NO. \_\_\_\_\_  
FILE NO. #108 Millington  
00 DEC 20 PM 2:42

*Gregory M. Field*

TUSCOLA COUNTY  
REGISTER OF DEEDS

For corners in: **MILLINGTON TWP.**

| <u>TUSCOLA</u><br>(County)            | Located In:               | Corner Code # |
|---------------------------------------|---------------------------|---------------|
| 1. Public Land Survey                 | T <u>10N</u> R <u>08E</u> | <u>K-6</u>    |
|                                       | T _____ R _____           | _____         |
|                                       | T _____ R _____           | _____         |
|                                       | T _____ R _____           | _____         |
| 2. Property Controlling in Section    | S _____ T _____ R _____   | _____         |
|                                       | S _____ T _____ R _____   | _____         |
| 3. Miscellaneous Property in Sec.     | S _____ T _____ R _____   | _____         |
|                                       | S _____ T _____ R _____   | _____         |
| 4. Lot No. _____, Recorded Plat _____ |                           |               |
| 5. Private Claims _____               |                           |               |

Register of Deeds Stamp & File Number

I, JONATHAN M. FIELD, in a field survey on AUGUST 17 2000, do hereby certify that under requirements of P.A. 74, Michigan P.A. of 1970, the corner points mentioned in lines 1 and 2 above were in conformance with regulations and rules therefore as required in the current manual of survey instructions of the United States Department of the Interior, Bureau of Land Management or by a decree of a Court of Law and/or that the corner points mentioned in lines 3, 4 and 5 above were in conformance with the rules of the Michigan Board of Land Surveyors or by a Decree of a Court of Law; established, re-established, monumented, re-monumented, recovered, found as expressed below:

**NOTE: Not more than 4 corners, all in the same town and range, may be recorded on this certificate.**

|    | A  | B  | C  | D  | E  | F  | G | H | I | J | K | L | M |
|----|----|----|----|----|----|----|---|---|---|---|---|---|---|
| 1  |    |    |    |    |    |    |   |   |   |   |   |   |   |
| 2  | 6  | 5  | 4  | 3  | 2  | 1  |   |   |   |   |   |   |   |
| 3  |    |    |    |    |    |    |   |   |   |   |   |   |   |
| 4  | 7  | 8  | 9  | 10 | 11 | 12 |   |   |   |   |   |   |   |
| 5  |    |    |    |    |    |    |   |   |   |   |   |   |   |
| 6  | 18 | 17 | 16 | 15 | 14 | 13 |   |   |   |   |   |   |   |
| 7  |    |    |    |    |    |    |   |   |   |   |   |   |   |
| 8  | 19 | 20 | 21 | 22 | 23 | 24 |   |   |   |   |   |   |   |
| 9  |    |    |    |    |    |    |   |   |   |   |   |   |   |
| 10 | 30 | 29 | 28 | 27 | 26 | 25 |   |   |   |   |   |   |   |
| 11 |    |    |    |    |    |    |   |   |   |   |   |   |   |
| 12 | 31 | 32 | 33 | 34 | 35 | 36 |   |   |   |   |   |   |   |
| 13 |    |    |    |    |    |    |   |   |   |   |   |   |   |


- A. Description of original monument and accessories and/or subsequent restoration:  
 1822 GLO; FLETCHER D.S.; SET POST; BEECH 9 N70E 4LKS., SUGAR 20 N85W 12LKS.  
 1892 FELTON, C.S.; NO OBJECT STATED; PINE 36 S12 1/2W 74LKS, BITTERNUT 5 S78°W 27 LKS.  
 1973 MITCHELL, P.S. #6936; LCRC PG.28; MON BOX; N88°W 64.58' POWER POLE, S80°W 38.04' TELEPHONE POLE, S80°E 52.03' 24" WILLOW  
 1973 BROWN, P.S. #17613; LCRC PG.31; 1/2" IRON ROD; N50°W 54.22' NAIL IN POWER POLE, S50°W 60.50' NAIL IN POWER POLE, N45°E 42.90' WEST POINT OF CONCRETE RIGHT-OF-WAY MARKER  
 1973 FLINT SURVEYING & ENG.; CARLSON, P.S. 9189; SURVEY, L.443 PG.382; MON BOX; EAST 36.65' NAIL IN 7" HICKORY, WEST 64.58' NAIL IN POWER POLE.  
 1974 COMMONWEALTH ASSOC.; SWARTS, P.S. #16945; SURVEY, L.441 PG.495-6; FND. BOAT SPIKE IN MON BOX; EAST 36.66' 7" ASH, S80°E 52.03' 30" WILLOW, S73°W 38.15' PHONE RISER  
 1974 COMMONWEALTH ASSOC.; SWARTS, P.S. #16945; SURVEY, L.444 PG.226-7; SAME AS 1974 SURVEY  
 1974 ROWE ENG.; ROWE, P.S. #11192; SURVEY, L.443 PG.266; RAILROAD SPIKE; N50W 33.60' 26" TWIN ELM, S45W 21.65' 28" MAPLE, E 30.55' CORNER FENCE POST  
 1974 ROWE ENG.; ROWE, P.S. #11192; SURVEY, L.443 PG.238; NO OBJECT OR WITS STATED  
 1974 SWARTS, P.S. #16945; LCRC PG.35; SAME AS 1974 COMMONWEALTH SURVEY  
 1978 ROWE ENG.; ROWE, P.S. #11192; SURVEY, L.494 PG.474; NO OBJECT STATED; NO WITS GIVEN

(SECTION A. CONTINUED ON BACK)

- B. Description of corner evidence found and/or method applied in restoring or reestablishing corner:  
 2000 ROWE; FIELD, P.S.#37276; FND. 5/8" ROD IN MON BOX; 0.4' W. OF C/L SHERIDAN RD., FENCE & TREE LINE TO E. & W.; RECOVERED 3 PREVIOUS WITS WHICH INDICATE THAT FND. ROD IS IN SAME POSITION AS 1973 MITCHELL LCRC CITED ABOVE.  
 ACCEPTED FND. ROD IN MON. BOX AS BEST AVAILABLE EVIDENCE OF ORIGINAL CORNER POSITION.

- C. Description of monument for corner and accessories established to perpetuate locating the position of the corner:  
 K-6 SET REMON CAP STAMPED K-6 T10N R8E ON FND. 5/8" ROD, ENCASED ROD & CAP IN CONC. IN MON BOX  
 N88°W 64.65' FND. NAIL W/DISK IN E. FACE P. POLE  
 S73°W 38.14 NAIL W/DISK IN N. FACE PHONE RISER POST  
 N30°W 130.41' NE COR. OF HOUSE #8740  
 EAST 36.61' FND. NAIL W/TAG #37276 IN N. FACE 10" ASH  
 N45°W 51.81' FND. NAIL W/TAG #37276 IN NE FACE OF 12" MAPLE  
 S80°E 54.35' NAIL IN S. FACE OF 24" WILLOW

Signed by *Jonathan M. Field* Date 11-10-2000  
 Surveyor's Michigan License No. 37276

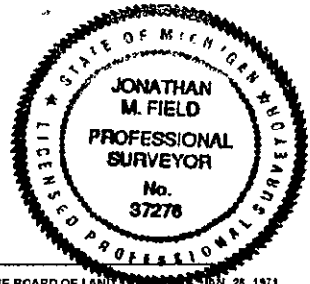

APPROVED 11/8/2000  
*KML*  
*RRB*

FORM APPROVED BY MICHIGAN STATE BOARD OF LAND SURVEYORS, JAN. 28, 1971  
 REVISED MAY 14, 1975  
 REVISED JAN, 1993  
 ADAPTED FOR WORD PROCESSING MARCH, 1993

COPY

**SURVEY &  
REMONUMENTATION**

FEB 08 2001

SECTION

COPY

SECTION A CONT. K-6 T10N-R8E

- 1985 GRAVLIN; GRAVLIN, P.S. #23510; SURVEY, L.553 PG.66; FND. 3/4" SQUARE ROD IN MON BOX; WEST 64.7' P; POLE, S60°E 53.4' 24" WILLOW; N30°W 130.36' NE COR. HOUSE
- 1989 DUNTON LAND SURVEYING; DUNTON, P.S. #23503; SURVEY, L.608 PG.1113; FND. BOAT SPIKE IN MON BOX; EAST 36.66' NAIL IN ASH, S80°E 53.4' SPIKE IN S FACE OF WILLOW, S73°W 38.15' PHONE PEDESTAL, N40°W 52.0' CENTER OF 10" MAPLE
- 1995 ROWE ENG.; FIELD, P.S. #37276; SURVEY, L.683 PG.18; BOAT SPIKE IN MON BOX; EAST 36.61' TAG #37276 N FACE ASH, S80°E 53.49' NAIL S FACE WILLOW, S73°W 37.26' TOP CTR PHONE RISER, N45°W 51.81' TAG #37276 IN NE FACE MAPLE
- 2000 SPICER; WOOD, P.S.#41115; UNRECORDED SURVEY JOB NO.S101360.00 DATED 4/18/00; NO OBJECT STATED; NO WITS GIVEN

\* PREVIOUS MEASUREMENTS WERE MADE TO IRON AT CENTERLINE PI OF MILLINGTON ROAD SEE 1993 REMON LCRC PG.90

