

**SURVEY & REMONUMENTATION**

**FEB 08 2001**

**2000 REMONUMENTATION  
LAND CORNER RECORDATION CERTIFICATE  
Filing Requirement of Act 74, Mich. P.A. 1970**

**SECTION**

RECEIVED FOR RECORD  
LIBER NO. \_\_\_\_\_ PAGE NO. \_\_\_\_\_  
FILE NO. #109 Millington  
00 DEC 20 PM 2:42

For corners in: **MILLINGTON TWP.**

<u>TUSCOLA</u> (County)	Located In:	Corner Code #
1. Public Land Survey	<u>T 10N R 08E</u>	<u>K-7</u>
	T _____ R _____	_____
	T _____ R _____	_____
	T _____ R _____	_____
2. Property Controlling in Section	S _____ T _____ R _____	_____
	S _____ T _____ R _____	_____
3. Miscellaneous Property in Sec.	S _____ T _____ R _____	_____
	S _____ T _____ R _____	_____
4. Lot No. _____	Recorded Plat _____	
5. Private Claims _____		

*Gregory M. Field*  
TUSCOLA COUNTY  
REGISTER OF DEEDS

Register of Deeds Stamp & File Number

	A	B	C	D	E	F	G	H	I	J	K	L	M
1													
2	6	5	4	3	2	1							
3													
4	7	8	9	10	11	12							
5													
6	18	17	16	15	14	13							
7													
8	19	20	21	22	23	24							
9													
10	30	29	28	27	26	25							
11													
12	31	32	33	34	35	36							
13													

I, JONATHAN M. FIELD, in a field survey on AUGUST 17 2000, do hereby certify that under requirements of P.A. 74, Michigan P.A. of 1970, the corner points mentioned in lines 1 and 2 above were in conformance with regulations and rules therefore as required in the current manual of survey instructions of the United States Department of the Interior, Bureau of Land Management or by a decree of a Court of Law and/or that the corner points mentioned in lines 3, 4 and 5 above were in conformance with the rules of the Michigan Board of Land Surveyors or by a Decree of a Court of Law; established, re-established, monumented, re-monumented, recovered, found as expressed below:

NOTE: Not more than 4 corners, all in the same town and range, may be recorded on this certificate.


- A. Description of original monument and accessories and/or subsequent restoration:
- 1822 GLO; FLETCHER D.S.; SET POST; BEECH 14 S57E 10 LKS., BEECH 18 S82W 19LKS.
  - 1882 TESKEY, C.S.; PG. 14-5; STAKE AT CORNER; NO WITS GIVEN.
  - 1892 FELTON, C.S.; PG. 204-5; NO OBJECT STATED; SCHOOL HOUSE S56 1/2W 128 LKS., SUGAR 6 N51 1/4E 64 LKS.
  - 1971 KAY ENG.; KAY, P.S. #14096; SURVEY, L.1 PG.90; ; N45°E 43.13' TRIANGULAR CONC. POST, N45°W 51.95' RD SIGN POST, S25°W 110.05' T.POLE
  - 1972 ROWE ENG.; ROWE, P.S. #11192; SURVEY, L.2 PG.354; FND. 1/2" ROD; N45°W 54.21' TAG #11192 IN T.POLE S45°W 60.52' TAG #11192 IN T.POLE, S25°W 121.76 NAIL IN 18" MAPLE, N45°E 43.08 W POINT OF TRIANGULAR CONC. MARKER
  - 1973 ROWE ENG.; ROWE, P.S. #11192; LCRC PG.19; SAME AS 1972 SURVEY
  - 1973 MITCHELL, P.S. #6936; LCRC, PG. 28; FND 1/2" BAR; N45°W 54.25' T.POLE, S45°W 60.53 T.POLE, S20°W 121.90' 24" MAPLE
  - 1973 KAY ENG.; KAY, P.S. #14096; SURVEY, L.436 PG.312; N45°W 54.21' TAG T. POLE, S45°W 60.52' TAG T.POLE, N45°E 43.08' W POINT OF TRIANGULAR CONC. MARKER

(SECTION A. CONTINUED ON BACK)

- B. Description of corner evidence found and/or method applied in restoring or reestablishing corner:
- 2000 ROWE; FIELD, P.S.#37276; FND, 1 1/2" PIPE IN MON BOX; ON C/L SHERIDAN RD & 1.5' N. OF C/L BARNES RD; RECOVERED 3 PREVIOUS WITS WHICH INDICATE THAT FND. PIPE IS IN SAME POSITION AS 1972 SURVEY CITED ABOVE.

ACCEPTED FND. PIPE IN MON. BOX AS BEST AVAILABLE EVIDENCE OF ORIGINAL CORNER POSITION.

- C. Description of monument for corner and accessories established to perpetuate locating the position of the corner:
- K-7 SET 5/8" ROD W/ REMON CAP STAMPED K-7 T10N R8E INSIDE FND. 1 1/2" PIPE, ENCASED ROD, CAP & PIPE IN CONC. IN MON BOX
  - N45°E 41.76' LEANING TRIANGULAR CONCRETE POST
  - N45°W 53.17' NE COR OF PHONE PEDESTAL
  - S45°W 59.75' CENTER OF PHONE PEDESTAL
  - S45°W 39.65' FND. 1/2" ROD W/CAP #20709
  - S25°W 113.00' NAIL W/TAG #37276 IN E. FACE 18" ELM

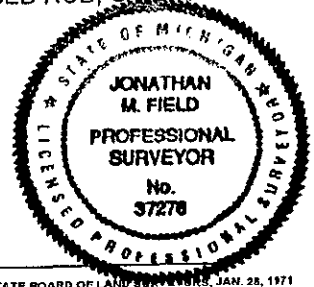

Signed by Jonathan M. Field Date 11-10-2000  
Surveyor's Michigan License No. 37276

FORM APPROVED BY MICHIGAN STATE BOARD OF LAND SURVEYORS, JAN. 28, 1971  
REVISED MAY 14, 1975  
REVISED JAN., 1983  
ADAPTED FOR WORD PROCESSING MARCH, 1993

APPROVED  
11/8/2000  
*KML*  
*RFB*

COPY

**SURVEY &  
REMONIFICATION**

FEB 08 2001

COPY

**SECTION**

SECTION A CONT. K-7 T10N-R8E

- 1974 FLINT SURVEYING & ENG.; CARLSON, P.S. #9189; SURVEY, L.443 PG.382; N50°W 54.22' NAIL IN P.POLE, S60°W 60.50' NAIL IN P.POLE, N45°W 42.93' W POINT OF CONC. R/W MARKER
- 1974 COMMONWEALTH ASSOC.; SWARTS, P.S. #16945; SURVEY, L.441 PG.495-6; FND 1/2" ROD; REF. TO LCRC PG.19
- 1974 COMMONWEALTH ASSOC.; SWARTS, P.S. #16945; SURVEY, L.444 PG.227; FND 1/2" ROD; REF. TO LCRC PG.19
- 1974 ROWE ENG.; ROWE, P.S. #11192; SURVEY, L.443 PG.266; 1/2" ROD N45W 54.21' TAG #11192 IN T.POLE, S45W 60.52' TAG #11192 IN T.POLE, S25W 121.76' NAIL IN 18" MAPLE
- 1974 ROWE ENG.; ROWE, P.S. #11192; SURVEY, L.443 PG.238; SAME AS 1973 ROWE
- 1978 ROWE ENG.; ROWE, P.S. #11192; SURVEY, L.494 PG.475; 1/2" ROD; N45°W 51.98' ROAD SIGN POST, N45W 54.21' TAG IN T.POLE, S45W 61.55' TAG IN T.POLE, N45°E 43.08' W POINT OF TRIANGULAR CONC. MARKER
- 1987 KAY ENG.; BROWN, P.S. #24588; SURVEY, L.578 PG.721; FND. 5/8" IRON IN MON BOX; N45°E 43.13' CONCRETE POST, N45°W 51.95' ROAD SIGN POST, S25°W 110.05' NAIL IN T.POLE
- 1989 DUNTON LAND SURVEYING; DUNTON, P.S. #23503; SURVEY, L.595 PG.064; FND. ROD IN MON BOX; N45W 51.98' ROAD SIGN POST, N45°E 43.08' W POINT OF CONC. MARKER, N45°W 3.4' PHONE PED., S45°W 60.0' PHONE PED.
- 1989 DUNTON LAND SURVEYING; DUNTON, P.S. #23503; SURVEY, L.608 PG.1113; FND. 1/2" ROD IN MON BOX; N45°W 53' PHONE PED., N45°E 42.0' CONC. MARKER, S45°E 62.2' SPIKE IN COR POST, S45°W 59.5' PHONE PED.
- 1992 ROWE ENG.; FIELD, P.S. #37276; SURVEY, L.632 PG.1335; FND. 1/2" ROD IN MON BOX; N45°E 41.63' W COR OF CONC. PROJECT MARKER, S50E 62.01' NAIL IN FENCE COR POST, N45°W 51.65' CENTER OF ROAD SIGN POST, S45°W 39.65' 1/2" ROD AND CAP #20709
- 1995 ROWE ENG.; FIELD, P.S. #37276; SURVEY, L.683 PG.018; SAME AS 1992 SURVEY ADDED S25°W 113.00' NAIL W/TAG #37276 IN E FACE 12" ELM
- 2000 SPICER; WOOD, P.S.#41115; UNRECORDED SURVEY JOB NO.S101360.00 DATED 4/18/00; NO OBJECT STATED; NO WITS GIVEN

