

SURVEY & REMONUMENTATION

FEB 08 2001

SECTION

**2000 REMONUMENTATION
LAND CORNER RECORDATION CERTIFICATE
Filing Requirement of Act 74, Mich. P.A. 1970**

RECEIVED FOR RECORD
LIBER NO. _____ PAGE NO. _____
FILE NO. **#104 Millington**
00 DEC 20 PM 2:42

Gregory M. Field
TUSCOLA COUNTY
REGISTER OF DEEDS

For corners in: **MILLINGTON TWP.**

<u>TUSCOLA</u> (County)	Located In:	Corner Code #
1. Public Land Survey	T <u>10N</u> R <u>08E</u>	<u>L-3</u>
	T _____ R _____	_____
	T _____ R _____	_____
	T _____ R _____	_____
2. Property Controlling In Section	S _____ T _____ R _____	_____
	S _____ T _____ R _____	_____
3. Miscellaneous Property in Sec.	S _____ T _____ R _____	_____
	S _____ T _____ R _____	_____

Register of Deeds Stamp & File Number

4. Lot No. _____, Recorded Plat _____
5. Private Claims _____

	A	B	C	D	E	F	G	H	I	J	K	L	M
1													
2	6	5	4	3	2	1							
3													
4	7	8	9	10	11	12							
5													
6	18	17	16	15	14	13							
7													
8	19	20	21	22	23	24							
9													
10	30	29	28	27	26	25							
11													
12	31	32	33	34	35	36							
13													

I, JONATHAN M. FIELD, in a field survey on AUGUST 17 2000, do hereby certify that under requirements of P.A. 74, Michigan P.A. of 1970, the corner points mentioned in lines 1 and 2 above were in conformance with regulations and rules therefore as required in the current manual of survey instructions of the United States Department of the Interior, Bureau of Land Management or by a decree of a Court of Law and/or that the corner points mentioned in lines 3, 4 and 5 above were in conformance with the rules of the Michigan Board of Land Surveyors or by a Decree of a Court of Law; established, re-established, monumented, re-monumented, recovered, found as expressed below:

NOTE: Not more than 4 corners, all in the same town and range, may be recorded on this certificate.


- A. Description of original monument and accessories and/or subsequent restoration:
 1822 GLO; FLETCHER D.S.; SET POST; BEECH 12 S25W 23 LKS., MAPLE 20 N52W 34 LKS.
 1894 FELTON, C.S.; PG 238-9; CEDAR POST, 2" TILE & CROCKERY AT CORNER; NO WITS GIVEN
 1941 BLACK, P.S. 3384; HUSTON'S SUBDIVISION; NO OBJECT STATED; NO WITS GIVEN
 1953 BLACK, P.S. 3384; FRED HUSTON'S SUBDIVISION; NO OBJECT STATED; NO WITS GIVEN
 1960 BLACK, P.S. 3384; FRED HUSTON SUBDIVISION NO.2; NO OBJECT STATED; NO WITS GIVEN
 1975 LEACH, P.S. 7236; SURVEY L.447 PG.902, L.450 PG.589, L.452 PG.583; FND. 3/8" ROD; REF. TO LCRC PG.37
 1975 LEACH, P.S. 7236; LCRC PG. 37; FND. 3/8" ROD; NORTH 43.0 NAIL W/TAG #11192 IN S. FACE P.POLE, S30E 35.30 W. FACE T.POLE, S45W 53.65 N. FACE 8" POPLAR
 1975 ROWE ENG.; BECK, P.S. 21559; SURVEY L.452 PG.610; SAME AS 1975 LCRC
 1975 ROWE, P.S. 11192; LCRC PG.44; FND. 3/4" PIPE 1.0' DEEP RAISED W/ ROD; SAME WITS AS 1975 LCRC
 1980 ROWE ENG.; FOKENS, P.S. 21567; SURVEY L.507 PG.1390; ROD; NORTH 42.70 TAG #11192 IN P.POLE, S40W 53.48 TAG #11192 IN 6" POPLAR, SOUTH 2' C/L MURPHY LAKE RD.
 1981 CHMP; MILLER, P.S. 12024; SURVEY L.514 PG.764-6; FND. ROD; N5W 42.65 P.POLE, S45W 53.62 6" POPLAR, S35E 86.22 3" MAPLE
 1983 DUNTON, P.S. 23503; SURVEY L.533 PG.527; NORTH 43' TAG IN P.POLE, S45W 53.65' NAIL IN 8" POPLAR, SOUTH 3' C/L PAVEMENT
 1985 ROWE ENG.; OWENS, P.S. 20709; SURVEY L.558 PG.711-6; SAME AS 1980 SURVEY

(SECTION A. CONTINUED ON BACK)

- B. Description of corner evidence found and/or method applied in restoring or reestablishing corner:
 2000 ROWE; FIELD, P.S.#37276; FND. 1/2" ROD OVER 1 1/4" PIPE 3' N. OF C/L MURPHY LAKE RD. & ON TREE LINE N. & S.; RECOVERED 1 PREVIOUS WIT WHICH INDICATES THAT FND. PIPE IS IN SAME POSITION AS 1975 LEACH LCRC CITED ABOVE.

ACCEPTED FND. PIPE AS BEST AVAILABLE EVIDENCE OF ORIGINAL CORNER POSITION

- C. Description of monument for corner and accessories established to perpetuate locating the position of the corner:
 L-3 SET 5/8" ROD W/ REMON CAP STAMPED L-3 T10N R8E OVER PIPE; ENCASED PIPE, ROD & CAP IN CONC. IN PLACED MON. BOX
 S75°E, 86.17' FND. NAIL W/TAG #20709 IN N. FACE 16" COTTONWOOD
 S40°W, 42.52' NAIL W/TAG #11192 IN NW FACE 8" POPLAR
 SOUTH, 33.54' FND. ROD W/CAP #20709
 NORTH, 33.44' FND. 1/2" ROD W/CAP #37276
 N05°W, 42.33' SET NAIL W/REMON TAG IN E. FACE P.POLE

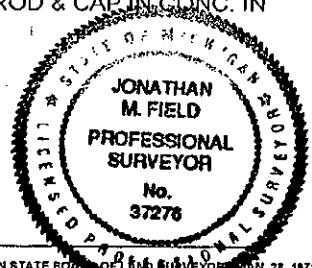

Signed by Jonathan M. Field Date 11-10-2000
 Surveyor's Michigan License No. 37276

APPROVED 11/8/2000
KML
RLB

FORM APPROVED BY MICHIGAN STATE BOARD OF LAND SURVEYORS JAN. 28, 1971
 REVISIONS: RECORDED MAY 14, 1975
 REVISED JAN., 1983
 ADAPTED FOR WORD PROCESSING MARCH, 1993

COPY

**SURVEY &
REMONUMENTATION**

FEB 08 2001

COPY

SECTION

SECTION A CONT. L-3 T10N-R8E

- 1991 ROWE ENG.; BROWN, P.S. 33134; SURVEY L.612 PG.883-4; FND ROD ABOVE 1 1/4" PIPE; SOUTH 33.49 ROD #20709, S40W 42.52 TAG #11192 IN 6" POPLAR, S50W 64.01 TAG #11192 IN 6" POPLAR, N5W 42.71 TAG #11192 IN P.POLE
- 1991 ROWE ENG.; FIELD, P.S. 37276; SURVEY L.619 PG.1033-5; FND. 1/2" ROD; S75E 86.17 TAG #20709 IN 12" COTTONWOOD, N5W 42.69' P-K W/TAG #20709 IN P.POLE, SOUTH 33.54 ROD W/CAP #20709, NORTH 33.44 1/2" ROD W/CAP #37276
- 1992 FIELD, P.S. 37276; LCRC PG.69; SAME AS 1991 SURVEY
- 1992 GRAVLIN, P.S. 23510; SURVEY L.637 PG.766-7; SAME AS 1983 SURVEY
- 1996 RC ASSOC.; FERGUSON, P.S. 26454; SURVEY L.692 PG.456-7; NO OBJECT STATED; NO WITS GIVEN
- 1997 ROWE ENG.; FIELD, P.S. 37276; SURVEY L.736 PG.939; SAME AS 1991 SURVEY L.619 PG.1033
- 1998 ROWE; FIELD, P.S. 37276; SURVEY L.757 PG.200-1; SAME AS 1991 SURVEY L.619 PG.1033
- 2000 ROWE; POWELL, P.S. 44298; SURVEY L.804 PG.016-7; SAME AS 1991 SURVEY L.619 PG.1033
- 2000 DAVIS LAND SURVEYING; HAY, P.S. 41101; SAME AS 1983 SURVEY ADDED SOUTH 33' FND. IRON

