

**SURVEY & REMONUMENTATION**

FEB 08 2001

**SECTION**

**2000 REMONUMENTATION  
LAND CORNER RECORDATION CERTIFICATE**  
Filing Requirement of Act 74, Mich. P.A. 1970

RECORDED FOR RECORD  
LIBER NO. \_\_\_\_\_ PAGE NO. \_\_\_\_\_  
FILE NO. #107 Millington  
00 DEC 20 PM 2:42

*Jonathan M. Field*  
TUSCOLA COUNTY  
REGISTER OF DEEDS

For corners in: **MILLINGTON TWP.**

<u>TUSCOLA</u> (County)	Located In:	Corner Code #
1. Public Land Survey	T <u>10N</u> R <u>08E</u>	<u>L-5</u>
	T _____ R _____	_____
	T _____ R _____	_____
	T _____ R _____	_____
2. Property Controlling in Section	S _____ T _____ R _____	_____
	S _____ T _____ R _____	_____
3. Miscellaneous Property in Sec.	S _____ T _____ R _____	_____
	S _____ T _____ R _____	_____

Register of Deeds Stamp & File Number

4. Lot No. \_\_\_\_\_, Recorded Plat \_\_\_\_\_  
5. Private Claims \_\_\_\_\_

	A	B	C	D	E	F	G	H	I	J	K	L	M
2	6	5	4	3	2	1							
3													
4	7	8	9	10	11	12							
5													
6	18	17	16	15	14	13							
7													
8	19	20	21	22	23	24							
9													
10	30	29	28	27	26	25							
11													
12	31	32	33	34	35	36							
13													

I, JONATHAN M. FIELD, in a field survey on AUGUST 17 2000 do hereby certify that under requirements of P.A. 74, Michigan P.A. of 1970, the corner points mentioned in lines 1 and 2 above were in conformance with regulations and rules therefore as required in the current manual of survey instructions of the United States Department of the Interior, Bureau of Land Management or by a decree of a Court of Law and/or that the corner points mentioned in lines 3, 4 and 5 above were in conformance with the rules of the Michigan Board of Land Surveyors or by a Decree of a Court of Law; established, re-established, monumented, re-monumented, recovered, found as expressed below:

NOTE: Not more than 4 corners, all in the same town and range, may be recorded on this certificate.


A. Description of original monument and accessories and/or subsequent restoration:  
1822 GLO; FLETCHER D.S.; SET POST; IRONWOOD 9 N45E 10LKS., BEECH 10 S63E 23LKS.  
1892 FELTON, C.S.; PG. 204-5; POST, CROCKERY & STONE BOTTLE CONTAINING NOTES AT CORNER; BUTTERNUT 5 S60E 78 LKS  
1894 FELTON, C.S.; PG. 238-9; NO OBJECT STATED; BUTTERNUT 5 S60E 78LKS.  
1971 ROWE ENG.; ROWE, P.S. #11192; SURVEY, L.1 PG.152-3; T-IRON IN MON BOX; N70W 185.76' NAIL W/CAP P.POLE, N80E 207.03' NAIL W/CAP P.POLE, SOUTH 38.95' NAIL W/CAP T.POLE  
1971 AMERICAN CIVIL ENG.; PIOTROWSKI, P.S. #9685; SURVEY, L.1 PG.224; T-BAR IN MON BOX; N65E 207.0' T.POLE, SOUTH 40.08' FENCE POST  
1972 MILLER, P.S. #12024; LCRC, PG.2; SAME AS 1971 AM. CIVIL ENG. SURVEY  
1972 KAY ENG.; KAY, P.S. #14096; SURVEY, L.2 PG.156; NO OBJECT STATED; SAME WITS AS 1971 ROWE SURVEY  
1986 ROWE ENG.; OWENS, P.S.#20709; SURVEY L.558 PG.711-6; SAME AS 1971 ROWE SURVEY

B. Description of corner evidence found and/or method applied in restoring or reestablishing corner:  
2000 ROWE; FIELD, P.S.#37276; FND. EMPTY MON BOX, SET 5/8" ROD IN CENTER; RECOVERED 2 PREVIOUS WITS WHICH INDICATE THAT SET ROD IS IN SAME POSITION AS 1971 SURVEY IN SECTION A. ABOVE

ACCEPTED SET ROD IN MON. BOX AS BEST AVAILABLE EVIDENCE OF ORIGINAL CORNER POSITION.

C. Description of monument for corner and accessories established to perpetuate locating the position of the corner:  
L-5 SET STD. REMON CAP STAMPED L5 T10N R8E ON 5/8" ROD IN MON BOX, ENCASED ROD W/CAP IN CONC.  
N70°W, 185.59' FND. NAIL W/CAP IN SE FACE P.POLE  
N80°E, 207.03' FND. NAIL W/CAP IN SW FACE P.POLE  
SOUTH, 40.12' FND. P-K NAIL IN W. FACE FENCE POST  
N05°W, 53.31' SET NAIL W/REMON TAG IN W. FACE P.POLE

Signed by Jonathan M. Field Date 11-10-2000  
Surveyor's Michigan License No. 37276

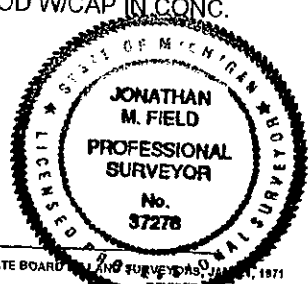

APPROVED ADD  
11/8/2000 RFB

FORM APPROVED BY MICHIGAN STATE BOARD OF SURVEYORS, 1971  
REVISED JAN., 1983  
ADAPTED FOR WORD PROCESSING MARCH, 1993

COPY

FEB 08 2001

SECTION

COPY

\* PREVIOUS MEASUREMENTS WERE MADE  
TO IRON AT CENTERLINE PI OF  
MILLINGTON ROAD SEE 1993 REMON  
LCRC PG.90

L-5 T10N-R8E

