

# SURVEY & REMONUMENTATION

FEB 08 2001

## 2000 REMONUMENTATION

SECTION

LAND CORNER RECORDATION CERTIFICATE

Filing Requirement of Act 74, Mich. P.A. 1970

RECEIVED FOR RECORD  
 LIBER NO. \_\_\_\_\_ PAGE NO. \_\_\_\_\_  
 FILE NO. #110 Millington  
 00 DEC 20 PM 2:42

For corners in: **MILLINGTON TWP.**

<u>TUSCOLA</u> (County)	Located In:	Corner Code #
1. Public Land Survey	T <u>10N</u> R <u>08E</u>	<u>L-7</u>
	T _____ R _____	_____
	T _____ R _____	_____
	T _____ R _____	_____
2. Property Controlling in Section	S _____ T _____ R _____	_____
	S _____ T _____ R _____	_____
3. Miscellaneous Property in Sec.	S _____ T _____ R _____	_____
	S _____ T _____ R _____	_____

*Jonathan M. Field*  
 TUSCOLA COUNTY  
 REGISTER OF DEEDS

Register of Deeds Stamp & File Number

4. Lot No. \_\_\_\_\_, Recorded Plat \_\_\_\_\_  
 5. Private Claims \_\_\_\_\_

	A	B	C	D	E	F	G	H	I	J	K	L	M
1													
2	6	5	4	3	2	1							
3													
4	7	8	9	10	11	12							
5													
6	18	17	16	15	14	13							
7													
8	19	20	21	22	23	24							
9													
10	30	29	28	27	26	25							
11													
12	31	32	33	34	35	36							
13													

I, JONATHAN M. FIELD, in a field survey on AUGUST 17 2000, do hereby certify that under requirements of P.A. 74, Michigan P.A. of 1970, the corner points mentioned in lines 1 and 2 above were in conformance with regulations and rules therefore as required in the current manual of survey instructions of the United States Department of the Interior, Bureau of Land Management or by a decree of a Court of Law and/or that the corner points mentioned in lines 3, 4 and 5 above were in conformance with the rules of the Michigan Board of Land Surveyors or by a Decree of a Court of Law; established, re-established, monumented, re-monumented, recovered, found as expressed below:

NOTE: Not more than 4 corners, all in the same town and range, may be recorded on this certificate.


A. Description of original monument and accessories and/or subsequent restoration:  
 1822 GLO; FLETCHER D.S.; SET POST; BEECH 14 N7W 9LKS., BEECH 16 S32W 35LKS.  
 1882 TESKEY, C.S.; PG.14-5; CAST IRON AROUND 5" TILE AND CROCKERY; STAKE SOUTH 50LKS.  
 1892 FELTON, C.S.; PG.204-5; NO OBJECT STATED; SUGAR 2 S1/2E 40 LKS., SUGAR 2 S62E 113 LKS.  
 1972 ROWE, P.S. #11192; LCRC, PG.19; FND 1 1/2" PIPE 24" DEEP, SET 3/8" ROD; NORTH 54.10' TAG #11192 IN P.POLE, S2E 51.72' NAIL IN P.POLE, S5E 38.40' TAG #11192 IN T.POLE, SOUTH 4.2' C/L OF ASPHALT ROAD  
 1972 ROWE ENG.; ROWE, P.S. #11192; SURVEY, L.2 PG.354; SAME AS 1972 LCRC  
 1973 KAY ENG.; KAY, P.S. #14096; SURVEY, L.436 PG.312; NO OBJECT STATED; SAME WITS AS 1972 LCRC ADDED N40E 101.22' SE COR TRAILER & S10E 37.90' T.POLE  
 1988 DUNTON, P.S. #23503; SURVEY, L.631 PG.935; FND. 1/2" IRON; NORTH 56.50' P-K IN E FACE P.POLE, S6E 38.20' TAG #11192 IN T.POLE STUB, S5E 51.65' NAIL IN E FACE P.POLE, SOUTH 3' C/L OF 22' PAVEMENT, N50E 61.4' CENTER 10" MAPLE  
 1989 DUNTON, P.S. #23503; SURVEY L.608 PG.1113-4; SAME AS 1988 SURVEY  
 1990 GRAVLIN, P.S.#23510; UNRECORDED SURVEY JOB NO.90-168 DATED 2-16-90; FND. 1/2" ROD; NORTH 56.57' P.POLE, S85E 38.18' TEL. PED. POST, S50E 57.0' 8" ASH  
 1990 ROWE ENG.; OWENS, P.S. #20709; SURVEY, L.609 PG.441-2; FND. 3/8" BENT ROD; NORTH 56.50' P-K IN P.POLE, S2E 51.72' NAIL IN P.POLE, S5E 38.40' NAIL W/TAG IN T.POLE, N10E 32.28' NAIL IN 8" MAPLE

B. Description of corner evidence found and/or method applied in restoring or reestablishing corner:  
 2000 ROWE; FIELD, P.S.#37276; FND. 1/2" ROD IN MON. BOX 3' N. OF C/L BARNES RD., TREE LINE TO N., FENCE & TREE LINE TO S.; RECOVERED 2 PREVIOUS WITS WHICH INDICATE THAT FND. ROD IS IN SAME POSITION AS 1972 LCRC CITED IN SECTION A. ABOVE.

ACCEPTED FND. ROD IN MON. BOX AS BEST AVAILABLE EVIDENCE OF ORIGINAL CORNER POSITION.

C. Description of monument for corner and accessories established to perpetuate locating the position of the corner:  
 L-7 SET 5/8" ROD W/ REMON CAP STAMPED L 7 T10N R8E OVER FND. ROD, ENCASED ROD & CAP IN CONC. IN MON. BOX  
 S02°E, 51.90' FND. NAIL IN E. FACE P.POLE  
 S05°E, 37.84' FND. NAIL W/TAG #11192 IN W. FACE CUT-OFF T.POLE  
 NORTH, 56.55' FND. P-K NAIL IN E. FACE P.POLE  
 N10°E, 37.16' FND. NAIL IN W. FACE 18" MAPLE  
 N50°E, 61.4' CENTER OF 14" MAPLE

Signed by Jonathan M. Field Date 11-10-2000  
 Surveyor's Michigan License No. 37276

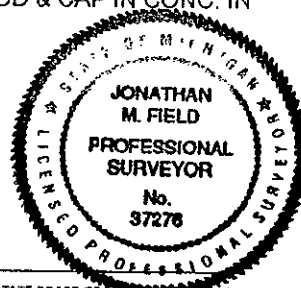

APPROVED  
11/8/2000  
*KMB*  
*RLB*

COPY

SURVEY &  
REMONUMENTATION

FEB 08 2001

SECTION

COPY

L-7 T10N-R8E

