SURVEY & REMONUMENTATION

FEB 08 2001

SECTION

__, Recorded Plat _

5. Private Claims

2000 REMONUMENTATION

LAND CORNER RECORDATION CERTIFICATE

Filing Requirement of Act 74, Mich. P.A. 1970

RECEIVED FOR RECORD LIBER NO. THE HO # 113 Millington 00 DEC 20 PH 2: 1,2

Grapho sun

For corners in: MILLINGTON TWP. TUSCOLA Located In: Corner Code # 1. Public Land Survey T 10N R 08E L-9 2. Property Controlling in Section 3. Miscellaneous

Register of Deeds Stamp & File Number Property in Sec.

points mentioned in lines 3, 4 and 5 above were in conformance with the rules of the Michigan Board of Land Surveyors or by a Decree of a Court of Law and/or that the corner points mentioned in lines 3, 4 and 5 and 5

(Court o	rere in conformance with the rules of the Michigan Board of Land Surveyors or by a Decree of a d below: Take the corner points mentioned in lines 3, 4 and 5 f Law; established, re-established, monumented, re-monumented, recovered, found as	8 9	19	2
١	IOTE:	₹	10 11	30	··· 2
			12	31	3:
- A	. De:	scription of original monument and accessories and/or subsequent sectoral			

1	A B	C D	E F	G H	l J	KLN
2 3	6	5	4	3	2	1
4 5	7	8	. 9	10	11	12
6	18	17	16	15	14	13
8	19	20	21	22	23	24
10 11	30	- 29	28	27	-26	25
12	31	32	33	34	35	36

Description of original monument and accessories and/or subsequent restoration:

1822 GLO; FLETCHER D.S.; SET POST; W. ASH 10 S40W 19 LKS., BEECH 9 N39E 24 LKS.
1882 TESKEY, C.S.; PG.14-5; OX SHOE & CROCKERY AT STAKE; W. ASH 10 S40W 19LKS., BEECH 9 N39E 24LKS.,

1973 ROWE ENG.; ROWE, P.S. #11192; SURVEY, L.2 PG.415-6; FND. 1/2" ROD; N50E 58.91' TAG #11192 IN 30" MAPLE, 540E 42.18' TAG #11192 IN 36" OAK, S25E 26.36' TAG #11192 IN 12 " HICKORY. 1975 ROWE, P.S. #11192; LCRC, PG.44; SAME AS 1973 SURVEY

1984 ROWE ENG.; ROWE, P.S. #11192; SURVEY, L.547 PG.389; SAME AS 1973 SURVEY

Description of corner evidence found and/or method applied in restoring or reestablishing corner:

ROWE; PoweII, P.S.; FND. 1/2" ROD IN C/L BIRCH RUN RD. (GRAVEL), FENCE & TREE LINE TO S.: RECOVERED 3 PREVIOUS WITS WHICH INDICATE THAT FND: ROD IS IN SAME POSITION AS 1973 SURVEY

ACCEPTED FND. ROD AS BEST AVAILABLE EVIDENCE OF ORIGINAL CORNER POSITION.

Description of monument for corner and accessories established to perpetuate locating the position of the corner: REPLACED FND. ROD W STD. REMON MONUMENT WCAP STAMPED L-9 T10N R8E

S60°E, 43.13' SET NAIL W/REMON TAG IN NE FACE 40" OAK S40°E, 26.91' SET NAIL W/REMON TAG IN NE FACE 14" HICKORY S65°W, 45.52' SET NAIL WIREMON TAG IN NW FACE 20" ASH N60°W, 29.06' SET NAIL WIREMON TAG IN SW FACE 10" ELM N60°E, 59.86' SET NAIL WREMON TAG IN NW FACE 38" ASH


(CAP STAMPED P.S. #37276)



Mark W Signed by Surveyor's Michigan License No.

Date _/2-/9-00

FORM APPROVED BY MICHIGAN STATE BOARD OF LAND SURVEYORS, JAN

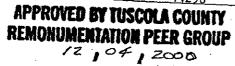









SURVEY & REMONUMENTATION

FEB 08 2001

SECTION

L-9, T10N-R8E

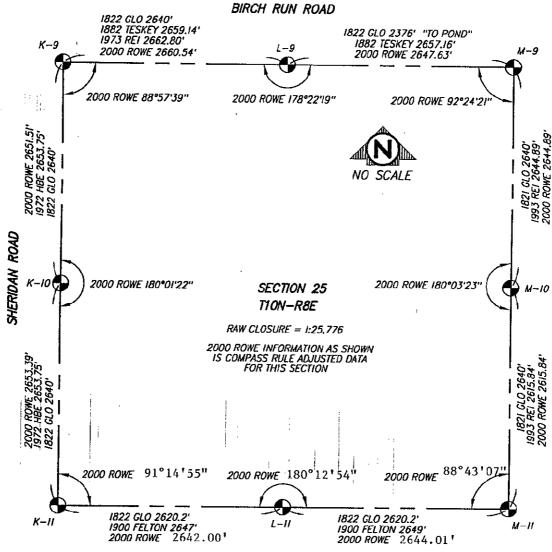

ARBELA ROAD