1993 REMONUMENTATION PROGRAM LAND CORNER RECORDATION CERTIFIC	CATE
COMMISSION Filling Requirement of Act 74, Mich. P.A.	1970
For corners in MILLINGTON TOWNSHIP	
TUSCOLA Located In: Corner Code #	SCENATOR
1. Public Land Survey T 10 N R 8 E M-2 T R T R T R 2. Property Controlling S T R in Section S T R	Marked National Control of the Second Contro
3. Miscellaneous S T R Property in Sec. S T R	Register of Deeds Stamp & File Number
Lot No, Recorded Plat Private Claims	A B C D E F G H I J K L M
J. Private dialins	2 5 2 1
l, JONATHAN M. FIELD , in a field survey on OCTOBER 19 93, do hereby certify that under requirements of P.A. 74, Michigan P.A. of 1970, the corner points mentioned in lines 1 and 2 above were in conformance with regulations and rules therefore as required in the current manual of survey instructions of the United States Department of the Interior, Bureau of Land Management or by a decree of a Court of Law and/or that the corner points mentioned in lines 3, 4 and 5 above were in conformance with the rules of the Michigan Board of Land Surveyors or by a Decree of a Court of Law; established, re-established, monumented, re-monumented, recovered, found as expressed below:	4 7 8 9 10 11 12 15 14 13 19 20 21 22 23 24 9
NOTE: Not more than 4 corners, all in the same town and range, may be recorded on this certificate.	10 30 29 28 27 26 25 11 12 31 32 33 34 35 36
A. Description of original monument and accessories and/or subsequent restoration: 1821 GLO - WAMPLER, D.S "1/4 S COR. IN LAKE OR ON THE ISLAND THEREIN"	13
NO SUBSEQUENT RECORD	
B. Description of corner evidence found and/or method applied in restoring or reestablishing now eng FIELD, P.S.#37276; CORNER FALLS IN MURPHY LAKE.	ng corner:
REESTABLISHED CORNER POSITION BY INTERSECTION OF LINE FROM M-1 THROUGH PLAT "MURPHY LAKE SUB." (UNRECORDED) AND LINE FROM L-2 THROUGH SE CORNER (LIBER 1 OF PLATS PG.33B)	·



SEE	ALSO	BACK	OF	THIS	FORM
_	_		-		

C.	Description of monument set withes monument	for corner and accessories	s established to perpetual	te locating the positi	on of the corner:	
M-2	SET WITNESS MONUMENT	(5/8" ROD W/BRASS CAP	ти соис) 712.90° и.	OF CORNER ON E.	TOWNSHIP LINE ON N.	SHORE OF

\$60°W, 51.61' FND 1/2" ROD W/CAP #23503

0.92' SET P-K NAIL IN S. FACE WOOD RETAINING WALL N25°W,

\$55°₩, 28.49' SET NAIL W/REMON TAG IN S. FACE 6" OAK

\$61°E, 12.58' SET NAIL W/REMON TAG IN TOP OF RETAINING WALL POST

886°E, 6.75' SW COR. 4'X6' SHED

\$16°W, 12.02' SET NAIL W/REMON TAG IN TOP OF RETAINING WALL POST

ON N. SHORE MURPHY LAKE 'n M. FIELD LAND SURVEYOR No.

Signed by Surveyor's Michigan License No. __


Date

FORM APPROVED BY NICHIGAN STATE BOARD OF LAND SURVEYORS, JAN. 28, 1971 REVISED MAY 14, 1975 REVISED JAN., 1983 ADAP1ED FOR WORD PROCESSING MARCH, 1993

APPROVED





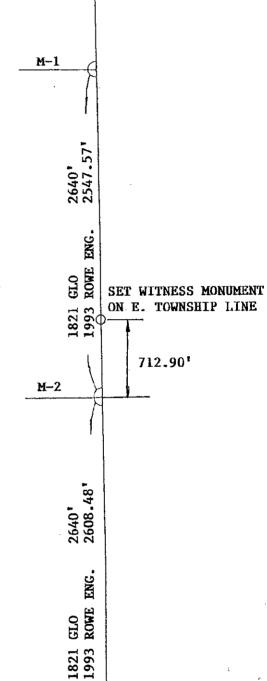

SECTION 1 TION-R8E

M-3