

1993

1993 REMONUMENTATION PROGRAM
LAND CORNER RECORDATION CERTIFICATE

Filing Requirement of Act 74, Mich. P.A. 1970

COMMISSION

For corners in
TUSCOLA
(County)

MILLINGTON TOWNSHIP
Located In: Corner Code #

1. Public Land Survey	T	10	N	R	8	E	M-3
	T		R				
	T		R				
	T		R				
2. Property Controlling in Section	S		T		R		
	S		T		R		
3. Miscellaneous Property in Sec.	S		T		R		
	S		T		R		

RECEIVED FOR RECORD
LIBER NO. _____ PAGE NO. 02
FILING NO. Millington
93 DEC 15 AM 10:33
MICHAEL J. MCLAUGHLIN
TUSCOLA COUNTY
REGISTER OF DEEDS

Register of Deeds Stamp & File Number

4. Lot No. _____ Recorded Plat _____
5. Private Claims _____

I, JONATHAN M. FIELD, in a field survey on OCTOBER 19 93, do hereby certify that under requirements of P.A. 74, Michigan P.A. of 1970, the corner points mentioned in lines 1 and 2 above were in conformance with regulations and rules therefore as required in the current manual of survey instructions of the United States Department of the Interior, Bureau of Land Management or by a decree of a Court of Law and/or that the corner points mentioned in lines 3, 4 and 5 above were in conformance with the rules of the Michigan Board of Land Surveyors or by a Decree of a Court of Law; established, re-established, monumented, re-monumented, recovered, found as expressed below:

NOTE: Not more than 4 corners, all in the same town and range, may be recorded on this certificate.


	A	B	C	D	E	F	G	H	I	J	K	L	M
1													
2	6	5	4	3	2	1							
3													
4	7	8	9	10	11	12							
5													
6	18	17	16	15	14	13							
7													
8	19	20	21	22	23	24							
9													
10	30	29	28	27	26	25							
11													
12	31	32	33	34	35	36							
13													

A. Description of original monument and accessories and/or subsequent restoration:
 1821 GLO - WAMPLER, D.S. - SET POST; TAMARACK 4" S46W 26 LKS., TAMARACK 4" N88E 7LKS.
 1894 FELTON, C.S. - SET FROM E.T.'S - POST, 2 HORSE SHOES & CROCKERY; NO WITS GIVEN,
 1985 ROWE ENG. - OWENS, P.S.#20709; SURVEY L.558, PG.711-716 - CORNER FALLS IN LAKE, WITNESS CORNER SET 337.22' WNW'LY ON N. LINE OF SEC.1
 1991 ROWE ENG. - BROWN, P.S.#33134; SURVEY L.612, PG.883-884 - CORNER FALLS IN LAKE, REFERS TO WITNESS CORNER 337.22' WNW'LY
 1991 ROWE ENG. - FIELD, P.S.#37276; SURVEY L.619, PG.1033-1035 - CORNER FALLS IN LAKE, REFERS TO WITNESS CORNER 337.22' WNW'LY

B. Description of corner evidence found and/or method applied in restoring or reestablishing corner:
 1993 ROWE ENG. - FIELD, P.S.#37276; CORNER FALLS IN MURPHY LAKE - REESTABLISHED PREVIOUSLY DETERMINED POSITION OF CORNER (1985 REI SURVEY CITED IN A. ABOVE) BY TRAVERSE FROM RECOVERED CONTROL POINTS
 ACCEPTED CALCULATED POSITION AS BEST EVIDENCE OF ORIGINAL CORNER POSITION

COPY

SEE ALSO BACK OF THIS FORM
 C. Description of monument for corner and accessories established to perpetuate locating the position of the corner:
 M-3 SET WITNESS MONUMENT (5/8" ROD W/BRASS CAP IN CONC) 440.13' S. OF CORNER ON E. TOWNSHIP LINE
 S84°E, 33.31' SET 1/2" ROD W/CAP #37276
 N36°E, 73.32' SET NAIL W/REMON TAG IN NW FACE 12" OAK
 S75°E, 30.30' SET NAIL W/REMON TAG IN S. FACE 8" OAK
 S27°E, 39.38' SET NAIL W/REMON TAG IN SW FACE 6" ELM
 S75°W, 12.24' SET NAIL W/REMON TAG IN S. FACE 10" POPLAR
 North, 60'+/- centerline of gravel road
 Westerly, 230'+/- centerline of 16'±culvert

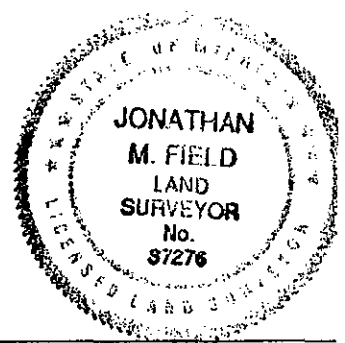

Signed by Jonathan M. Field Date 12-14-93
 Surveyor's Michigan License No. 37276

APPROVED
 12-13-93
 J.M.F.
 J.M.F.

COPY



SECTION 1
T10N-R8E

SECTION 12
T10N-R8E

