

1993

1993 REMONUMENTATION PROGRAM
LAND CORNER RECORDATION CERTIFICATE

COMMISSION

Filing Requirement of Act 74, Mich. P.A. 1970

MILLINGTON TOWNSHIP

For corners in
TUSCOLA
(County)

Located In:

Corner Code #

- 1. Public Land Survey T 10 NR 8 E M-4
- T R
- T R
- T R
- 2. Property Controlling S T R
- in Section S T R
- 3. Miscellaneous S T R
- Property in Sec. S T R

- 4. Lot No. _____ Recorded Plat _____
- 5. Private Claims _____

RECEIVED FOR RECORDS
 LIBSEN NO. _____ PAGE NO. 01
 FILED BY Hilltopper
 93 DEC 15 AM 10:32
 VERNER J. MILLINGTON
 TUSCOLA COUNTY
 REGISTER OF DEEDS

Register of Deeds Stamp & File Number

I, JONATHAN M. FIELD, in a field survey on OCTOBER 19 93, do hereby certify that under requirements of P.A. 74, Michigan P.A. of 1970, the corner points mentioned in lines 1 and 2 above were in conformance with regulations and rules therefore as required in the current manual of survey instructions of the United States Department of the Interior, Bureau of Land Management or by a decree of a Court of Law and/or that the corner points mentioned in lines 3, 4 and 5 above were in conformance with the rules of the Michigan Board of Land Surveyors or by a Decree of a Court of Law; established, re-established, monumented, re-monumented, recovered, found as expressed below:

NOTE: Not more than 4 corners, all in the same town and range, may be recorded on this certificate.

	A	B	C	D	E	F	G	H	I	J	K	L	M
2	6	5	4	3	2	1							
3													
4	7	8	9	10	11	12							
5													
6	18	17	16	15	14	13							
7													
8	19	20	21	22	23	24							
9													
10	30	29	28	27	26	25							
11													
12	31	32	33	34	35	36							
13													

A. Description of original monument and accessories and/or subsequent restoration:

- 1821 GLO - WAMPLER, D.S. - SET 1/2 MILE POST AT CEDAR SWAMP; PINE 16" N87W 4LKS., CEDAR 11" S41E 24LKS.
- 1894 FELTON, C.S. - SET FROM B.T. - CEDAR POST, 2 HORSE SHOES & CROCKERY; NO WITS GIVEN
- 1985 ROWE ENG. - OWENS, P.S.#20709; SURVEY L.558, P.711-716 - CORNER FALLS IN LAKE, WITNESS CORNERS SET 62.71' W'ly AND 366.42' W'LY ON E-W 1/4 LINE

B. Description of corner evidence found and/or method applied in restoring or reestablishing corner:


- 1993 ROWE ENG. - FIELD, P.S.#37276; CORNER FALLS IN MURPHY LAKE - REESTABLISHED PREVIOUSLY DETERMINED POSITION (1985 REI SURVEY CITED IN A. ABOVE) BY TRAVERSE FROM RECOVERED CONTROL POINTS
- ACCEPTED CALCULATED POSITION AS BEST EVIDENCE OF ORIGINAL CORNER POSITION

COPY

SEE ALSO BACK OF THIS FORM

C. Description of monument for corner and accessories established to perpetuate locating the position of the corner:

- M-5 SET WITNESS MONUMENT (5/8" ROD W/BRASS CAP IN CONC) 100.00' S. OF CORNER ON E. TOWNSHIP LINE
- N12°W, 24.76' SET NAIL W/REMON TAG IN W. FACE 6" CEDAR
- S66°W, 24.56' SET NAIL W/REMON TAG IN S. FACE 12" MAPLE
- S18°W, 23.11' SET NAIL W/REMON TAG IN SE FACE 10" ELM
- S20°E, 25.58' SET NAIL W/REMON TAG IN E. FACE 10" MAPLE
- S77°E, 30.85' SET NAIL W/REMON TAG IN SW FACE 14" CEDAR
- NORTH, 0.68' SET CARSONITE MARKER POST

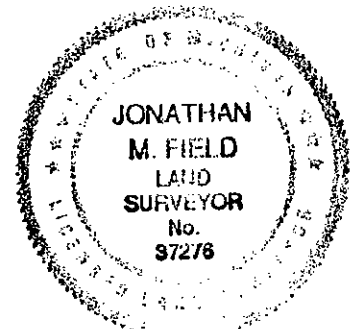

Signed by Jonathan M. Field

Date 12-14-93


Surveyor's Michigan License No. 37276

APPROVED
 12-13-1993
J.M.F.

COPY



SECTION 12
TOWNSHIP-R8E

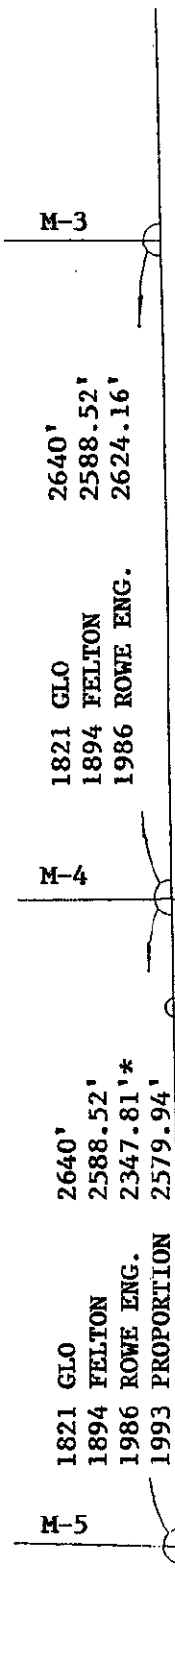

* NOTE: THIS DISTANCE WAS MEASURED TO
A BOAT SPIKE N. OF M-5 WHICH WAS
PREVIOUSLY HELD AS THE CORNER

SET WITNESS MONUMENT
ON E. TOWNSHIP LINE