

1993

COMMISSION

1993 REMONUMENTATION PROGRAM
LAND CORNER RECORDATION CERTIFICATE
Filing Requirement of Act 74, Mich. P.A. 1970
MILLINGTON TOWNSHIP

RECEIVED FOR RECORD
LIBERED PAGE NO. 96
FILING NO. Millington
93 DEC 15 AM 10:32
VASSILAKIS, JAMES
TUSCOLA COUNTY
REGISTER OF DEEDS

For corners in
TUSCOLA
(County)

Located In: _____ Corner Code # _____

1. Public Land Survey	T 10 N R 8 E	M-5
	T _____ R _____	_____
	T _____ R _____	_____
	T _____ R _____	_____
2. Property Controlling in Section	S _____ T _____ R _____	_____
	S _____ T _____ R _____	_____
3. Miscellaneous Property in Sec.	S _____ T _____ R _____	_____
	S _____ T _____ R _____	_____

Register of Deeds Stamp & File Number

4. Lot No. _____, Recorded Plat _____

5. Private Claims _____

I, JONATHAN M. FIELD, in a field survey on OCTOBER 19 93, do hereby certify that under requirements of P.A. 74, Michigan P.A. of 1970, the corner points mentioned in lines 1 and 2 above were in conformance with regulations and rules therefore as required in the current manual of survey instructions of the United States Department of the Interior, Bureau of Land Management or by a decree of a Court of Law and/or that the corner points mentioned in lines 3, 4 and 5 above were in conformance with the rules of the Michigan Board of Land Surveyors or by a Decree of a Court of Law; established, re-established, monumented, re-monumented, recovered, found as expressed below:

NOTE: Not more than 4 corners, all in the same town and range, may be recorded on this certificate.

	A	B	C	D	E	F	G	H	I	J	K	L	M
1													
2	6	5	4	3	2	1							
3													
4	7	8	9	10	11	12							
5													
6	18	17	16	15	14	13							
7													
8	19	20	21	22	23	24							
9													
10	30	29	28	27	26	25							
11													
12	31	32	33	34	35	36							
13													

- A. Description of original monument and accessories and/or subsequent restoration:
- 1821 GLO - WAMPLER, D.S. - SET POST; BEECH 16" N16E 14 1/2LKS., BEECH 12" S32W 10LKS.
 - 1892 FELTON, C.S. - SET FROM MEAS. - OAK POST AND CROCKERY, NO WITS GIVEN
 - 1894 FELTON, C.S. - SET FROM MEAS. - OAK POST AND CROCKERY, NO WITS GIVEN
 - 1955 H.A. LAKE; SURVEY FOR MILLINGTON RD RELOCATION (PLANS ON FILE AT TUSCOLA CO. RD. COMM. DATED 1958)
NO OBJECT STATED, NO WITS GIVEN OTHER THAN STATION AND OFFSET; CORNER SHOWN IN SAME RELATIVE POSITION AS IRON FOUND (SEE SECTION B. BELOW)
 - 1974 SWARTS, P.S.#16945; LCRC PG.34 - FOUND BOAT SPIKE; S27E 90.52' E. END CULVERT, S22W 74.05' W. END CULVERT S49E 146.93' 14" OAK
 - 1986 ROWE ENG. - OWENS, P.S.#20709; SURVEY L.558, PG.711-716 - FND BOAT SPIKE; WITS SAME AS 1974 LCRC ABOVE
 - 1989 OWENS, P.S.#20709; LCRC PG.66 - FND BOAT SPIKE LEANING, REPLACED W/ 1/2" ROD W/CAP #20709; N42°W 63.46' 12" PINE, N52°W 51.35' FND ROD W/CAP #14096, S46°E 28.14' SIGN POST, S18°W 74.10' "+" TOP W. END CULVERT S28°E 90.80' "+" TOP E. END CULVERT


- B. Description of corner evidence found and/or method applied in restoring or reestablishing corner:
- 1993 ROWE ENG. - FIELD, P.S.#37276; FND 1/2" ROD W/CAP #20709 AND 5 PREV. WITS WHICH VERIFY THAT ROD IS IN SAME POSITION AS 1986 SURVEY -- DID NOT ACCEPT --, MEASUREMENTS ALONG E. LINE OF SECTION AND TOWNSHIP IN COMPARISON TO CO. SURVEYOR MEASUREMENTS INDICATE THAT CORNER SHOULD BE 200'-250' S. OF FND ROD
 - REESTABLISHED CORNER BY SINGLE PROPORTION AND ON LINE EXTENDED FROM M-4 THROUGH FND ROD W/CAP #20709 (DISTANCE BETWEEN L-5 AND FND ROD IS W/IN 0.5' OF CO. SURVEYOR MEASUREMENT)

COPY

SEE ALSO BACK OF THIS FORM

- C. Description of monument for corner and accessories established to perpetuate locating the position of the corner:

- M-5 SET STANDARD MONUMENT (5/8" ROD W/BRASS CAP IN CONC)
NORTH, 232.13' FND 1/2" ROD W/CAP #20709
S42°W, 30.62' FND 1/2" ROD W/BROKEN ORANGE CAP (UNREADABLE)
N41°E, 13.76' SET NAIL W/REMON CAP IN W. FACE 10" POPLAR
N86°E, 7.45' SET NAIL W/REMON TAG IN S. FACE 8" POPLAR
S13°W, 20.74' SET NAIL W/REMON TAG IN E. FACE 8" POPLAR
N79°W, 30.05' SET NAIL W/REMON TAG IN S. FACE 4" POPLAR

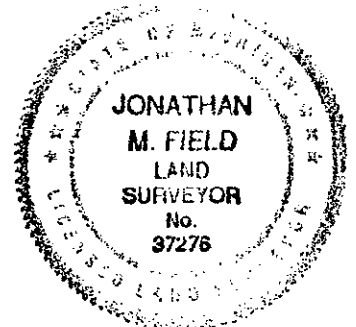

Signed by Jonathan M. Field Date 12-14-93

Surveyor's Michigan License No. 37276


APPROVED
12-13-1993
J.M.F.

COPY



SECTION 12
TION-R8E

SECTION 13
TION-R8E

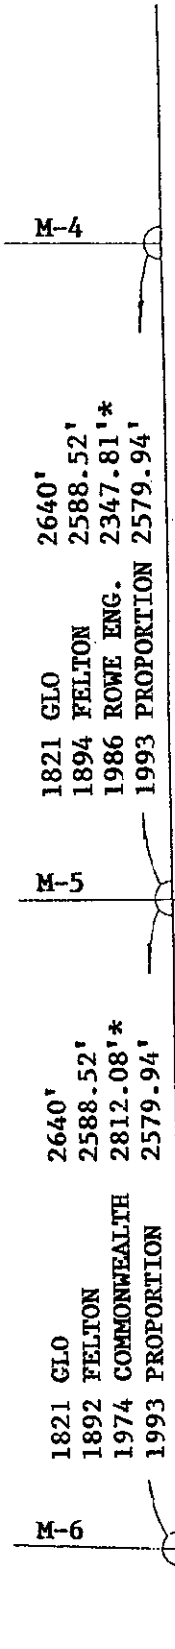

* NOTE: THESE DISTANCES WERE MEASURED TO A BOAT SPIKE 232.13' N. OF M-5