

1993

1993 REMONUMENTATION PROGRAM  
LAND CORNER RECORDATION CERTIFICATE

COMMISSION

Filing Requirement of Act 74, Mich. P.A. 1970

MILLINGTON TOWNSHIP

For corners in

TUSCOLA

(County)

Located In:

Corner Code #

1. Public Land Survey	T	10	NR	8	E	M-7
	T		R			
	T		R			
	T		R			
2. Property Controlling in Section	S	T	R			
	S	T	R			
3. Miscellaneous Property in Sec.	S	T	R			
	S	T	R			

4. Lot No. \_\_\_\_\_, Recorded Plat \_\_\_\_\_  
 5. Private Claims \_\_\_\_\_

I, JONATHAN M. FIELD, in a field survey on OCTOBER 19 93, do hereby certify that under requirements of P.A. 74, Michigan P.A. of 1970, the corner points mentioned in lines 1 and 2 above were in conformance with regulations and rules therefore as required in the current manual of survey instructions of the United States Department of the Interior, Bureau of Land Management or by a decree of a Court of Law and/or that the corner points mentioned in lines 3, 4 and 5 above were in conformance with the rules of the Michigan Board of Land Surveyors or by a Decree of a Court of Law, established, re-established, monumented, re-monumented, recovered, found as expressed below.

NOTE: Not more than 4 corners, all in the same town and range, may be recorded on this certificate.

A. Description of original monument and accessories and/or subsequent restoration:

- 1821 GLO - WAMPLER, D.S. - SET POST; BEECH 12" SOUTH (NO DIST), BEECH 7" N44W 46LKS.
- 1882 TESKEY, C.S. - STAKE; STAKE N45W 71 LKS., ELM (NO SIZE) S47 1/2W 60LKS.
- 1892 FELTON, C.S. - POST & CROCKERY; W.ASH 3" N9 3/4W 143LKS.
- 1969 TUSCOLA CO. RD. COMM; WIT CARD - FND PIPE PUT IN 5/8" ROD 4' LONG; NE 32.3' FE POST, SE 82.55' T.POLE, SW 96.80' T.POLE
- 1969 FLINT SURVEYING; UNRECORDED SURVEY DWG. NO. 1993B - NO OBJECT STATED NO WITS GIVEN; 2571.81' TO M-8
- 1974 SWARTS, P.S.#16945; LCRC PG.34 - SET P-K NAIL, SE 82.55' T.POLE, SW 96.80' T.POLE
- 1979 LEACH ENG. - LEACH, P.S.#7236; SURVEY L.500 PG.735-736 - FND 1/2" ROD, NO WITS GIVEN; 2571.69' TO M-8
- 1981 FOKENS, P.S.#21567; LCRC PG.55 - FND 5/8" RE-BAR, S20E 82.55' NAIL IN T.POLE, S50W 96.80' NAIL IN T.POLE NORTH 8.0' C/L BARNES ROAD (WEST), CORNER ON E. EDGE OF ASPH.
- 1984 ROWE ENG. - ROWE, P.S.#11192; SURVEY L.547 PG. 389-390 - NO OBJECT STATED, NO WITS GIVEN
- 1988 DUNTON LAND SURVEYING - DUNTON, P.S.#23503; SURVEY L.631 PG.935 - FND 3/4" IRON N60W 86.9' P-K IN T.POLE STUB, S45W 96' PHONE PED., S25E 82.5' PHONE PED., S65W 64' RD SIGN POST, SOUTH 6.5' C/L FVMT. W., WEST 10' C/L FVMT. N-S (SECTION A. CONTINUED ON BACK OF THIS FORM)

B. Description of corner evidence found and/or method applied in restoring or reestablishing corner:

- 1993 ROWE ENG. - FIELD, P.S.#37276; FND 5/8" X 4' ROD, POINTED WOOD POST 1' LONG AND PIECES OF CROCKERY ACCEPTED FND 5/8" ROD AS BEST EVIDENCE OF ORIGINAL CORNER POSITION

SEE ALSO BACK OF THIS FORM

C. Description of monument for corner and accessories established to perpetuate locating the position of the corner:

- M-8 REMOVED ROD, POST, AND CROCKERY SET STANDARD MONUMENT (5/8" ROD W/ BRASS CAP IN CONC.) IN MON. BOX
- N65°W, 86.82' SET NAIL W/REMON TAG ABOVE FND P-K NAIL IN NE FACE CUT-OFF T.POLE
- N25°E, 42.90' SET NAIL W/REMON TAG ABOVE FND NAIL IN NW FACE TWIN 8" ELM
- S53°W, 113.39' SET NAIL W/REMON TAG IN NW FACE TWIN 8" ELM
- S51°W, 95.9' TOP CENTER OF PHONE RISER
- S22°E, 82.3' TOP CENTER OF PHONE RISER

RECEIVED FOR RECORD  
 LIBER. NO. \_\_\_\_\_ PAGE NO. 88  
 FILMS NO. Hillington  
 93 DEC 15 AM 10:32  
 VIRGINIA H. JAMES  
 TUSCOLA COUNTY  
 REGISTER OF DEEDS


Register of Deeds Stamp & File Number

1	A	B	C	D	E	F	G	H	I	J	K	L	M
2	6	5	4	3	2	1							
3													
4	7	8	9	10	11	12							
5													
6	18	17	16	15	14	13							
7													
8	19	20	21	22	23	24							
9													
10	30	29	28	27	26	25							
11													
12	31	32	33	34	35	36							
13													

COPY

Signed by Jonathan M. Field  
 Surveyor's Michigan License No. 37276

Date 12-6-93

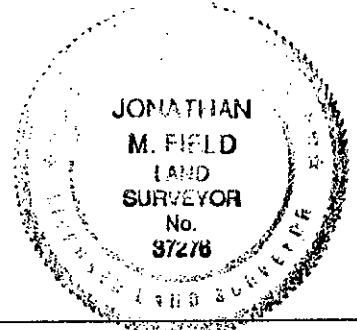


APPROVED  
12-6-93  
*J.M.F.*

COPY



SECTION 13  
TION-R8E

SECTION 24  
TION-R8E

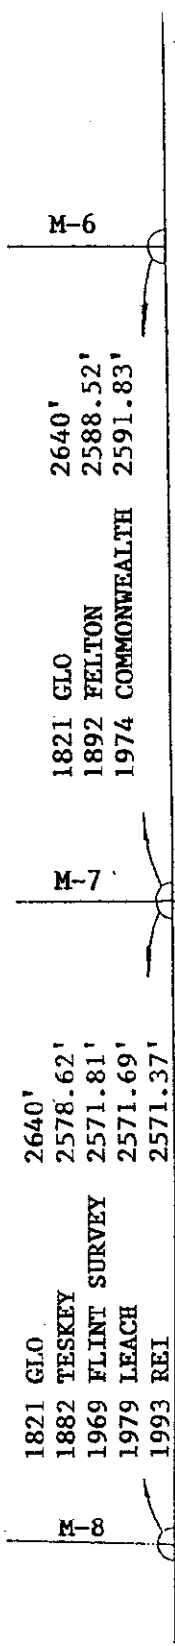

Description of original monument and accessories and/or subsequent restoration:  
 1890 GRAVELIN LAND SURVEY - GRAVELIN, P.S.#23510; UNRECORDED SURVEY JOB NO. 90-168 - FND 5/8" IRON AT E. EDGE OF PMNT.; 520E 83.0' T. POLE, S45W 95.8' 1. PED., N45W 86.8' 1. PED., WEST 9' C/L N-S RD.  
 1990 ROWE ENG. - OWENS, P.S.#20709; SURVEY I. 609 PG. 441-442 - FND 5/8" ROD; N65W 86.89' NAIL IN T. POLE, S45W 48.95' SET ROD W/CAP, SOUTH 29.60' SET ROD W/CAP, N25E 42.90' NAIL IN TWIN 8" RIM  
 1991 ROWE ENG. - FIELD, P.S.#37276; SURVEY I. 619 PG. 1063-1064 - FND 5/8" ROD; SAME WITS AS 1990 REI SURVEY