


COPY



SECTION 24
T10N-R8E

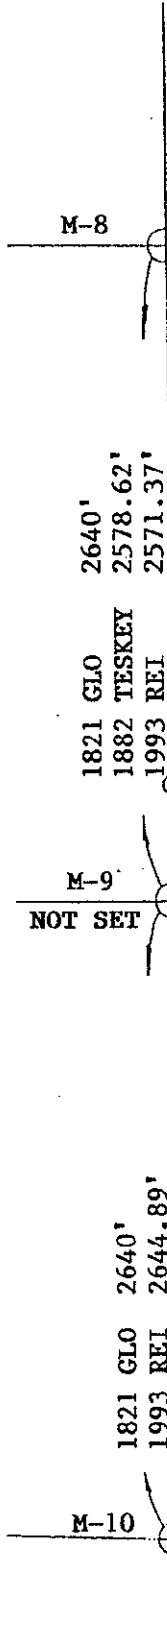

SECTION 25
T10N-R8E

SET WITNESS MONUMENT

668.63'

NOT SET

M-10

M-9

M-8

1821 GLO 2640'
1882 TESKEY 2578.62'
1993 REI 2571.37'

1821 GLO 2640'
1993 REI 2644.89'