

1933

1993 REMONUMENTATION PROGRAM  
LAND CORNER RECORDATION CERTIFICATE

COMMISSION

Filing Requirement of Act 74, Mich. P.A. 1970

For corners in  
TUSCOLA  
(County)

Located In: MILLINGTON TOWNSHIP  
Corner Code #

- 1. Public Land Survey T 10 N R 8 E M-12
- T R
- T R
- T R
- 2. Property Controlling S T R
- in Section S T R
- 3. Miscellaneous S T R
- Property in Sec. S T R

- 4. Lot No. \_\_\_\_\_, Recorded Plat \_\_\_\_\_
- 5. Private Claims \_\_\_\_\_

I, JONATHAN M. FIELD, in a field survey on OCTOBER 19 93, do hereby certify that under requirements of P.A. 74, Michigan P.A. of 1970, the corner points mentioned in lines 1 and 2 above were in conformance with regulations and rules therefore as required in the current manual of survey instructions of the United States Department of the Interior, Bureau of Land Management or by a decree of a Court of Law and/or that the corner points mentioned in lines 3, 4 and 5 above were in conformance with the rules of the Michigan Board of Land Surveyors or by a Decree of a Court of Law; established, re-established, monumented, re-monumented, recovered, found as expressed below:

NOTE: Not more than 4 corners, all in the same town and range, may be recorded on this certificate.

A. Description of original monument and accessories and/or subsequent restoration:  
1821 GLO - WAMPLER, D.S. - SET 1/2 MILE POST; BIRCH 5" N43E 14 LKS., BIRCH 6" N83W 7 1/2LKS.  
1900 FELTON, C.S. - SET FROM B.T.'S IN 1879; CEDAR POST BRICK AND CROCKERY; NO WITS GIVEN.  
NO SUBSEQUENT RECORD.


B. Description of corner evidence found and/or method applied in restoring or reestablishing corner:  
1993 ROWE ENG. - FIELD, P.S.#37276; END NO EVIDENCE OF CORNER OTHER THAN OLD FENCE RUNNING N-S MEASUREMENT FROM M-13, T10N-R8E TO M-11, T10N-R8E IS 16.5' SHORTER THAN 1900 CO. SURVEY DIST (TERRAIN IS HILLY WITH SEVERAL SWAMPY AREAS)  
REESTABLISHED CORNER BY PROPORTIONMENT OF 1900 CO. SURVEYOR DISTANCES AND ON LINE BETWEEN NE & SE CORNERS OF SEC. 36, T10N-R8E; CORNER FALLS IN SWAMP.

SEE ALSO BACK OF THIS FORM  
C. Description of monument for corner and accessories established to perpetuate locating the position of the corner:  
M-12 SET WITNESS MONUMENT (5/8" ROD W/ BRASS CAP IN CONC.) 139.09' N. OF M-12 ON E. TOWNSHIP LINE  
N34°E, 28.79' SET NAIL W/REMON TAG IN NW FACE 16" OAK  
N66°E, 12.89' SET NAIL W/REMON TAG IN N. FACE 10" POPLAR  
S62°E, 32.18' SET NAIL W/REMON TAG IN S. FACE 10" BEECH  
S42°W, 21.79' SET NAIL W/REMON TAG IN SE FACE 28" OAK  
S61°W, 18.91' SET NAIL W/REMON TAG IN S. FACE 10" BEECH

RECEIVED FOR RECORD  
LIBER NO. \_\_\_\_\_ PAGE NO. 83  
FILING NO. Millington  
93 DEC 15 AM 10:32  
VIRGINIA H. WILKINSON  
TUSCOLA COUNTY  
REGISTER OF DEEDS  
Register of Deeds Stamp & File Number

1	A	B	C	D	E	F	G	H	I	J	K	L	M
2	6	5	4	3	2	1							
3													
4	7	8	9	10	11	12							
5													
6	18	17	16	15	14	13							
7													
8	19	20	21	22	23	24							
9													
10	30	29	28	27	26	25							
11													
12	31	32	33	34	35	36							
13													

COPY

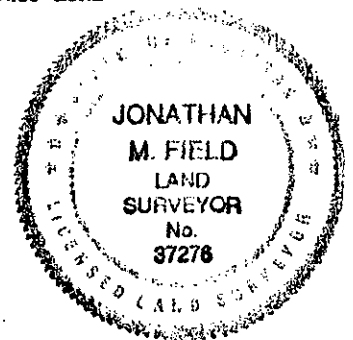

Signed by Jonathan M. Field Date 12-6-93  
Surveyor's Michigan License No. 37276

APPROVED  
12-6-93  
J.M.F.

COPY



SECTION 36  
TION-R8E

