

1993

1993 REMONUMENTATION PROGRAM
LAND CORNER RECORDATION CERTIFICATE

COMMISSION

Filing Requirement of Act 74, Mich. P.A. 1970

MILLINGTON TOWNSHIP

For corners in
TUSCOLA
(County)

Located In:

Corner Code #

1. Public Land Survey	T	10	N	R	8	E	M-13
	T		R				
	T		R				
	T		R				
2. Property Controlling in Section	S		T		R		
	S		T		R		
3. Miscellaneous Property in Sec.	S		T		R		
	S		T		R		

RECORDED FOR RECORD
LIBER NO. PAGE NO. 82
FILED IN Millington
59 DEC 15 AM 10:32
MICHIGAN LAND SURVEYORS
TUSCOLA COUNTY
REGISTER OF DEEDS

Register of Deeds Stamp & File Number

4. Lot No. _____, Recorded Plat _____
5. Private Claims _____

I, JONATHAN M. FIELD, in a field survey on OCTOBER 19 93, do hereby certify that under requirements of P.A. 74, Michigan P.A. of 1970, the corner points mentioned in lines 1 and 2 above were in conformance with regulations and rules therefore as required in the current manual of survey instructions of the United States Department of the Interior, Bureau of Land Management or by a decree of a Court of Law and/or that the corner points mentioned in lines 3, 4 and 5 above were in conformance with the rules of the Michigan Board of Land Surveyors or by a Decree of a Court of Law; established, re-established, monumented, re-monumented, recovered, found as expressed below:

NOTE: Not more than 4 corners, all in the same town and range, may be recorded on this certificate.

	A	B	C	D	E	F	G	H	I	J	K	L	M
1													
2	6	5	4	3	2	1							
3													
4	7	8	9	10	11	12							
5													
6	18	17	16	15	14	13							
7													
8	19	20	21	22	23	24							
9													
10	30	29	28	27	26	25							
11													
12	31	32	33	34	35	36							
13													

A. Description of original monument and accessories and/or subsequent restoration:


1821 GLO - WAMPLER, D.S. - SET POST; TAMARACK 12" S74 1/2E 19 LKS., ASH 21" N80W 43LKS.
1900 FELTON, C.S. - SET FROM B.T.'S IN 1879; CEDAR POST AND CROCKERY; NO WITS GIVEN, "STAKE STANDS ON EXTREME E. SIDE OF POINT EXTENDING INTO S. SIDE OF POWDER HORN LAKE"
NO SUBSEQUENT RECORD

COPY

B. Description of corner evidence found and/or method applied in restoring or reestablishing corner:

1993 ROWE ENG. - FIELD, P.S.#37276; FND 1/2" PIPE ON E. SIDE OF POINT ON S. SIDE OF POWDER HORN LAKE IN BOGGY AREA, MEASUREMENT W. TO K-13, TION-RSE IS W/IN 3.5' OF 1900 CO. SURVEY DISTANCE, NO EVIDENCE OF OCCUPIED LINE TO S., POWDER HORN LAKE TO N.; FND NO OTHER EVIDENCE.

ACCEPTED FND 1/2" PIPE AS BEST EVIDENCE OF ORIGINAL CORNER POSITION

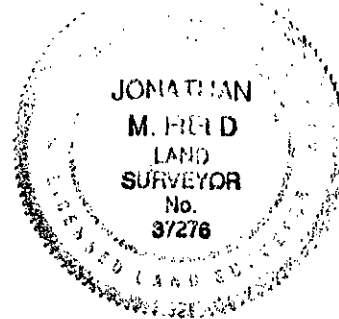

SEE ALSO BACK OF THIS FORM

C. Description of monument for corner and accessories established to perpetuate locating the position of the corner:

M-13 REMOVED 1/2" PIPE SET 5/8" X 6" ROD W/STANDARD BRASS CAP SET WITNESS MONUMENT (5/8" ROD W/BRASS CAP IN CONC) ON
 S60°W, 45.30' SET NAIL W/REMON TAG IN S. FACE 10" MAPLE S28°W, 24.17' SET NAIL W/REMON TAG 12" OAK TWP. LI
 N75°W, 68.32' SET NAIL W/REMON TAG IN SW FACE 12" ASH N82°W, 23.01' SET NAIL W/REMON TAG 10" POPLAR
 S88°W, 45.75' SET NAIL W/REMON TAG IN S. FACE 8" WILLOW N43°W, 24.14' SET NAIL W/REMON TAG 8" MAPLE
 N48°W, 118.75' SET NAIL W/REMON TAG IN SW FACE 16" ASH N28°E, 88.67' SET NAIL W/REMON TAG IN SW FACE 16" ASH
 N50°W, 156.55' SET 1/2" ROD W/CAP #37276 N06°E, 101.63' SET 1/2" ROD W/CAP #37276
 S70°W, 93.30' SET 1/2" ROD W/CAP #37276 S53°E, 52.88' SET 1/2" ROD W/CAP #37276
 WEST, 130.00' SET WITNESS MONUMENT ON S. TWP. LINE EAST, 130.00' SET 5/8" X 6" ROD W/BRASS CAP AT M-13
 N16°E, 23.37' SET NAIL W/REMON TAG 24" OAK
 N49°E, 26.68' SET NAIL W/REMON TAG 28" OAK

Signed by Jonathan M. Field Date 12-9-93
 Surveyor's Michigan License No. 37276

APPROVED
 12-8-93
 J.M.F.

COPY

M-12

1993 REI 2640.62'
1900 FELTON 2649.0'
1821 GLO 2640'

SECTION 6
T9N-R9E
LAPEER COUNTY

M-13

130.00'

SET WITNESS
MONUMENT



SECTION 36
T10N-R8E

TUSCOLA COUNTY

1821 GLO 2640'
1900 FELTON 2620'
1993 REI 2621.74'

F-13

SECTION 1
T9N-R8E

GENESEE COUNTY