

MAY 05 1997

**1996 REMONUMENTATION PROGRAM**  
**LAND CORNER RECORDATION CERTIFICATE**

Filing Requirement of Act 74, Mich. P.A. 1970

**COMMISSION**

For corners in WATERTOWN TWP.

TUSCOLA  
(County)

Located In:

Corner Code #

- 1. Public Land Survey T 10N R 09E  
T \_\_\_\_\_ R \_\_\_\_\_  
T 11N R 09E  
T \_\_\_\_\_ R \_\_\_\_\_
- 2. Property Controlling S \_\_\_\_\_ T \_\_\_\_\_ R \_\_\_\_\_  
in Section S \_\_\_\_\_ T \_\_\_\_\_ R \_\_\_\_\_
- 3. Miscellaneous S \_\_\_\_\_ T \_\_\_\_\_ R \_\_\_\_\_  
Property in Sec. S \_\_\_\_\_ T \_\_\_\_\_ R \_\_\_\_\_

A-1 ✓  
\_\_\_\_\_  
A-13  
\_\_\_\_\_  
\_\_\_\_\_  
\_\_\_\_\_

- 4. Lot No. \_\_\_\_\_, Recorded Plat \_\_\_\_\_
- 5. Private Claims \_\_\_\_\_

I, JONATHAN M. FIELD, in a field survey on JULY 14 19 94, do hereby certify that under requirements of P.A. 74, Michigan P.A. of 1970, the corner points mentioned in lines 1 and 2 above were in conformance with regulations and rules therefore as required in the current manual of survey instructions of the United States Department of the Interior, Bureau of Land Management or by a decree of a Court of Law and/or that the corner points mentioned in lines 3, 4 and 5 above were in conformance with the rules of the Michigan Board of Land Surveyors or by a Decree of a Court of Law; established, re-established, monumented, re-monumented, recovered, found as expressed below:

NOTE: Not more than 4 corners, all in the same town and range, may be recorded on this certificate.

**A. Description of original monument and accessories and/or subsequent restoration:**

1834 GLO; PARKE, D.S.; SET POST; BEECH 9 S61E 22LKS., BEECH 6 N76E 25LKS.  
1993 CORNERSTONE; BONNO, P.S.#32332; SURVEY FOR TIMOTHY MCLEOD DATED 6-10-93; FND T-IRON 2' DEEP, SET 1/2" ROD; EAST 32.38' RD SIGN, N78E 58.6' STOP SIGN, N45E 159.50' P.POLE, S45E 41.1' CORNER POST, S15E 48.0' CORNER POST

**B. Description of corner evidence found and/or method applied in restoring or reestablishing corner:**

1994 ROWE ENG.; FIELD, P.S.#37276; FND. 1/2" ROD OVER T-IRON (3' DEEP) 4' N. OF C/L-C/L OF ASPH. ROAD N-S AND GRAVEL ROAD E. 3 PREVIOUS WITNESSES INDICATE THAT 1/2" ROD IS IN SAME POSITION AS 1993 CORNERSTONE IRON

ACCEPTED 1/2" ROD AND T-IRON AS BEST EVIDENCE OF ORIGINAL CORNER POSITION

**C. Description of monument for corner and accessories established to perpetuate locating the position of the corner:**

A-1 REMOVED ROD AND T-IRON, SET STANDARD REMON MONUMENT STAMPED "A 13 T11N R9E" IN MON. BOX  
S57°E, 47.06' SET NAIL W/REMON TAG IN N. FACE 8"X8" FENCE POST  
S23°E, 48.41' SET NAIL W/REMON TAG IN N. FACE 12" FENCE POST  
WEST, 32.98' CENTER OF ROAD SIGN POST  
N71°W, 111.83' SET NAIL W/REMON TAG IN S. FACE T.POLE  
N45°E, 161.10' SET NAIL W/REMON TAG IN W. FACE T.POLE  
N78°E, 58.6' S. EDGE OF STOP SIGN POST


✓ This corner is common with A-13 T11N-R9E

NOTE: MONUMENT AND ACCESSORIES SET 9-2-94

Signed by Jonathan M. Field Date 12-23-96

Surveyor's Michigan License No. 37276

APPROVED  
12-11-96  
L.H.C.  
R.D.B.

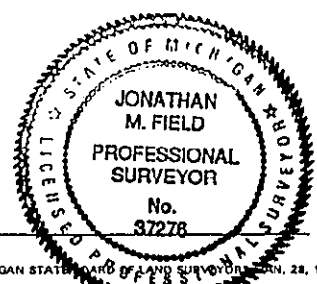

FORM APPROVED BY MICHIGAN STATE BOARD OF LAND SURVEYORS, JAN. 28, 1971  
REVISED MAY 14, 1975  
REVISED JAN., 1983  
ADAPTED FOR WORD PROCESSING MARCH, 1993

	A	B	C	D	E	F	G	H	I	J	K	L	M
1													
2	6	5	4	3	2	1							
3													
4	7	8	9	10	11	12							
5													
6	18	17	16	15	14	13							
7													
8	19	20	21	22	23	24							
9													
10	30	29	28	27	26	25							
11													
12	31	32	33	34	35	36							
13													

RECEIVED FOR RECORD  
LIBER NO. \_\_\_\_\_ PAGE NO. 76  
FILE NO. WaterTownTwp  
96 DEC 26 AM 11:50  
TUSCOLA COUNTY  
REGISTER OF DEEDS  
Register of Deeds Stamp & File Number

SEE ALSO 1993 REMONUMENTATION  
L.C.R.C. 80



M-11  
T11N-R8E

WASHBURN ROAD



748.48'

89°51'43"

A-13  
ON E. TWP.  
LINE

M-12  
T11N-R8E


SEE ALSO 1993 REMONUMENTATION  
L.C.R.C. 79

SEC 31  
T11N-R9E

1834 G.L.O. 2640'  
1993 CORNERSTONE 2656.19'  
1994 REI 2648.12'

BROWN ROAD

SEC 6  
T10N-R9E

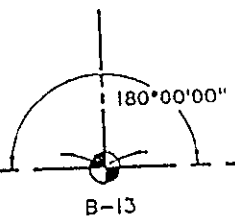

B-13

SEE ALSO 1994  
REMONUMENTATION  
L.C.R.C. FOR B-13