

COPY

DEC 07 1994

1994 REMONUMENTATION PROGRAM  
LAND CORNER RECORDATION CERTIFICATE

COMMISSION

Filing Requirement of Act 74, Mich. P.A. 1970

For corners in WATERTOWN TOWNSHIP

TUSCOLA  
(County)

Located In:

Corner Code: //

- 1. Public Land Survey T 10N R 9E B-13  
T \_\_\_\_\_ R \_\_\_\_\_  
T \_\_\_\_\_ R \_\_\_\_\_  
T \_\_\_\_\_ R \_\_\_\_\_
- 2. Property Controlling S \_\_\_\_\_ T \_\_\_\_\_ R \_\_\_\_\_  
in Section S \_\_\_\_\_ T \_\_\_\_\_ R \_\_\_\_\_
- 3. Miscellaneous S \_\_\_\_\_ T \_\_\_\_\_ R \_\_\_\_\_  
Property in Sec. S \_\_\_\_\_ T \_\_\_\_\_ R \_\_\_\_\_

- 4. Lot No. \_\_\_\_\_, Recorded Plat \_\_\_\_\_
- 5. Private Claims \_\_\_\_\_

RECEIVED FOR RECORD  
LIBER NO. \_\_\_\_\_ PAGE NO. \_\_\_\_\_  
FILING NO. # 70  
WATER TOWN, MI  
94 NOV - 9 PM 2:20  
VIRGINIA H. HALLARIN  
TUSCOLA COUNTY  
REGISTER OF DEEDS

Register of Deeds Stamp & File Number

I, Lionel Roy Emery in a field survey on May 16, 1994, do hereby certify that under requirements of P.A. 74, Michigan P.A. of 1970, the corner points mentioned in lines 1 and 2 above were in conformance with regulations and rules therefore as required in the current manual of survey instructions of the United States Department of the Interior, Bureau of Land Management or by a decree of a Court of Law and/or that the corner points mentioned in lines 3, 4 and 5 above were in conformance with the rules of the Michigan Board of Land Surveyors or by a Decree of a Court of Law; established, re-established, monumented, re-monumented, recovered, found as expressed below:

NOTE: Not more than 4 corners, all in the same town and range, may be recorded on this certificate.

	A	B	C	D	E	F	G	H	I	J	K	L	M
2	6		5		4		3		2		1		
3													
4	7		8		9		10		11		12		
5													
6	13		17		16		15		14		13		
7													
8	19		20		21		22		23		24		
9													
10	30		29		28		27		26		25		
11													
12	31		32		33		34		35		36		
13													

A. Description of original monument and accessories and/or subsequent restoration:

- 1834 (Gov't. Land Office Notes) Harvey Parke, D.S. -set quarter Section post- W. Birch 9 N20E 82; Hemlock 12 N33W 1.08
- 1898 (County Surveyor's Record, pages 320 and 321, Tuscola County) George B. Felton, County Surveyor -Did not perpetuate--corner position within approximately 1/4 chain of closing on Township line on East side of T10N-R8E

B. Description of corner evidence found and/or method applied in restoring or reestablishing corner:

This position is not accessible due to being inundated by 'Beaver Pond'  
Position of corner established by single proportioning to Parke's 1834 measurements.  
Placed reference corner Monument in South Section line 289.22 feet Easterly from calculated position. The South line of Section 31 being held at remains of old Woven wire fence found throughout Section West of "Hart Lake", so-called.




C. Description of monument for corner and accessories established to perpetuate locating the position of the corner:

Placed Standard Tuscola County Concrete Monument with 2" Brass Cap stamped B 13 W.C. T10N-R9E. Note: accessories shown below are for the reference marker.  
N65°E, 7.42' -T.C. Remon. tag in North face of 8" Oak  
S20°W, 9.79' -T.C. Remon. tag in East face of 5" Ash  
N82°W, 22.39' -T.C. Remon. tag in North face of 24" Poplar  
N45°W, 31.19' -T.C. Remon. tag in Northeast face of 8" White Birch  
East. 0.85' -"Survey Marker" witness post  
West (alg Sec. line), 60.00' -Concrete Monument with Brass Cap stamped A 13 W.C. T10N-R9E

Signed by Lionel Roy Emery Date Nov. 7, 1994  
Surveyor's Michigan License No. 24593

APPROVED  
11-7-94  
HOP  
JMT.

TUSCOLA COUNTY  
MILLINGTON TWP.  
T10N-R8E

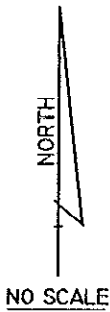

M 11  
T10N-R8E

TUSCOLA COUNTY  
WATERTOWN TWP.  
T10N-R9E

S.W. 1/4 OF SECTION 31

S.E. 1/4 OF SECTION 31

SET WITNESS MONUMENT  
TO "A 13"

SET WITNESS MONUMENT  
TO "B 13"

245'

289.22'

60'

A 13 EMERY 1994 15.78 FT. B 13  
PARKE 1834 15.84 FT.

180°00'00"  
EMERY 1994 2630.28 FT. C 13  
PARKE 1834 2640 FT.

FELTON 1890 2645 FT. (SECTION MEASUREMENT)  
EMERY 1994 2646.06 FT. (SECTION MEASUREMENT)

(No Road)

M 12: T10N-R8E

LAPEER COUNTY  
MARATHON TWP.  
T9N-R9E

COPY

COPY