

DEC 07 1994

COMMISSION

1994 REMONUMENTATION PROGRAM  
LAND CORNER RECORDATION CERTIFICATE

Filing Requirement of Act 74, Mich. P.A. 1970

For corners in WATERTOWN TOWNSHIP

<u>TUSCOLA</u> (County)	Located In:	Corner Code: //
1. Public Land Survey	T 10N R 9E	E-13
	T _____ R _____	_____
	T _____ R _____	_____
	T _____ R _____	_____
2. Property Controlling in Section	S _____ T _____ R _____	_____
	S _____ T _____ R _____	_____
3. Miscellaneous Property in Sec.	S _____ T _____ R _____	_____
	S _____ T _____ R _____	_____
4. Lot No. _____, Recorded Plat _____		
5. Private Claims _____		

COPY

RECEIVED FOR RECORD  
LIBER NO. \_\_\_\_\_ PAGE NO. \_\_\_\_\_  
FILING NO. # 73  
WATERTOWN TWP  
94 NOV -9 PM 2:20  
VIRGINIA H. MALACHUK  
TUSCOLA COUNTY  
REGISTER OF DEEDS

Register of Deeds Stamp & File Number

I, Lionel Roy Emery in a field survey on May 16, 1994, do hereby certify that under requirements of P.A. 74, Michigan P.A. of 1970, the corner points mentioned in lines 1 and 2 above were in conformance with regulations and rules therefore as required in the current manual of survey instructions of the United States Department of the Interior, Bureau of Land Management or by a decree of a Court of Law and/or that the corner points mentioned in lines 3, 4 and 5 above were in conformance with the rules of the Michigan Board of Land Surveyors or by a Decree of a Court of Law; established, re-established, monumented, re-monumented, recovered, found as expressed below:

NOTE: Not more than 4 corners, all in the same town and range, may be recorded on this certificate.

A	B	C	D	E	F	G	H	I	J	K	L	M
2	6	5	4	3								
3												
4	7	8	9	10	11	12						
5												
6	18	17	16	15	14	13						
7												
8	19	20	21	22	23	24						
9												
10	30	29	28	27	26	25						
11												
12	31	32	33	34	35	36						
13												

A. Description of original monument and accessories and/or subsequent restoration:


- 1834 (Gov't. Land Office Notes) Harvey Parke, D.S. -set post corner Sections 32 and 33- Pine 40 N65W 9; Beech 9 N40E 9
- 1892 (Tuscola County Surveyor's Record, pages 192 and 193) G.B. Felton, County Surveyor, identified corner from bearing trees, placed Cedar post & crockery--no accessories and no distance to West 1/4 cor. or South 1/4 cor. given on Section Plat.
- 1966 (from Roscoe Black, P.S. witness card file) 1/2" iron rod as per Scott Eng. Co.- N50°W, 52.50' 18" Elm; N85°E, 88.85'-2" Cedar
- 1979 (Rowe Engineering, Inc. records)-found 1" Axle shaft- S70°W, 6.79'-nail in PP; S80°W, 69.22'-nail in PP; S15°W, 33.70'-N.W. corner of Garage; West 165.00'-NE corner., Sec. 5, T9N-R9E (also notes that Scott Eng. Co. used wrong corner. (Continued over)

B. Description of corner evidence found and/or method applied in restoring or reestablishing corner:

Found Axle shaft 165' East of iron in Monument Box at intersection of North Lake and Castle Road  
Accepted Axle shaft as marking original corner.

C. Description of monument for corner and accessories established to perpetuate locating the position of the corner:

Removed Axle shaft and replaced with Standard Tuscola County Concrete Monument w/ 2" Brass Cap stamped E13 T10N R9E  
N10°E, 41.56'-T.C. Remon.tag in West face 48" Maple  
S70°E, 34.25'-T.C. Remon.tag in S.W. face 16" Cherry  
S45°W, 6.82'-T.C. Remon.tag in N.W. face Pwr. Pole  
S70°W, 69.47'-T.C. Remon.tag in N.W. face Pwr. Pole  
West, 1'+/- -Witness Post

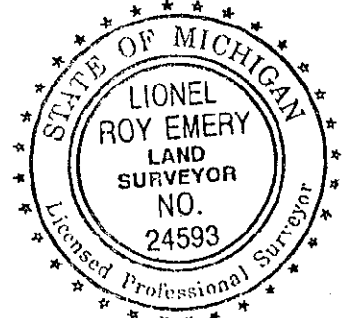

Signed by Lionel Roy Emery Date July 11, 1994  
Surveyor's Michigan License No. 24593

APPROVED  
7-11-94

1979 (Survey-Liber 503, Pages 1247 and 1248) Earl Gravin, P.S. 23510 -found Axle shaft-accessories same as Rowe Engineering, Inc. records.  
 1981 (Survey-Liber 516, Pages 329 and 330) David Rowe, P.S. 11192 shows corner-no accessories  
 1987 (Survey-Liber 576, Page 17) Robert Kay, P.S. 14096 -found 1" Axle shaft-S70°W 6.79' nail  
 P.P.; S80°W 69.22' Nail P.P.; S15°W 33.70' NW Cor Garage; West 165.0' NE Cor, Sec 5, T9N-R9E  
 1898 (County Surveyor's Record, pages 318 and 319, Tuscola County) George B. Felton, County Surveyor -previously set from Bearing Trees -Pine 40 N65W 7; Pine Root post & Crockery corner.

**COPY**

NO SCALE

