

OCT 20 1994

COMMISSION

1994 REMONUMENTATION PROGRAM
LAND CORNER RECORDATION CERTIFICATE
Filing Requirement of Act 74, Mich. P.A. 1970

For corners in WATERTOWN TOWNSHIP

TUSCOLA (County)	Located In:	Corner Code #
1. Public Land Survey	T <u>10N</u> R <u>9E</u>	<u>I-13</u>
	T _____ R _____	_____
	T _____ R _____	_____
	T _____ R _____	_____
2. Property Controlling in Section	S _____ T _____ R _____	_____
	S _____ T _____ R _____	_____
3. Miscellaneous Property in Sec.	S _____ T _____ R _____	_____
	S _____ T _____ R _____	_____

RECEIVED FOR RECORD
LIBER NO. _____ PAGE NO. _____
FILING NO. # 54
WATERTOWN TWP.
9/10 OCT - 4 AM 10:33
VIRGINIA N. HOLMSEN
TUSCOLA COUNTY
REGISTER OF DEEDS
Register of Deeds Stamp & File Number

4. Lot No. _____, Recorded Plat _____
5. Private Claims _____


	A	B	C	D	E	F	G	H	I	J	K	L	M
2	6		5		4		3		2		1		
3													
4	7		8		9		10		11		12		
5													
6	18		17		16		15		14		13		
7													
8	19		20		21		22		23		24		
9													
10	30		29		28		27		26		25		
11													
12	31		32		33		34		35		36		
13													

I, Lionel Roy Emery in a field survey on May 18, 19 94, do hereby certify that under requirements of P.A. 74, Michigan P.A. of 1970, the corner points mentioned in lines 1 and 2 above were in conformance with regulations and rules therefore as required in the current manual of survey instructions of the United States Department of the Interior, Bureau of Land Management or by a decree of a Court of Law and/or that the corner points mentioned in lines 3, 4 and 5 above were in conformance with the rules of the Michigan Board of Land Surveyors or by a Decree of a Court of Law; established, re-established, monumented, re-monumented, recovered, found as expressed below:

NOTE: Not more than 4 corners, all in the same town and range, may be recorded on this certificate.

- A. Description of original monument and accessories and/or subsequent restoration:
- 1834 (Gov't. Land Office Notes) Harvey Parke, D.S. -set post cor. Sections 34 and 35- Hemlock 12 N22E 5; Hemlock 8 N79W 6 1/2
 - 1973 (Survey by Rowe Engineering, Inc.) David Rowe, P.S. 11192 -set 1/2" re-rod - N20°E, 73.50'-11192 tag in 15" Maple; N25°E, 54.30' - "+" on road sign post; S20°W, 28.73' 11192 tag in TP
 - 1974 (Land Corner Recordation Certificate, Watertown, page 26) David Rowe, P.S. 11192 -set 1/2" re-rod on line between S 1/4 cor. Sec. 35, T10N-R9E and NE cor. Sec. 3, T9N-R9E and at ctrline of Edward Road to North. N20°E, 73.50'-11192 tag in 15" Maple; N25°E, 54.30'-Road sign post; S20°W, 28.73'- 11192 tag in TP
 - 1975 (Survey -Liber 453, page 103) Robert Kay, P.S. 14096 -found 1/2" rod- S15°W 29.15'-nail in Anchor Pole; N45°W, 34.25' -nail in cor. post; N30°E, 73.40'-nail in 18" Maple (See over)
- B. Description of corner evidence found and/or method applied in restoring or reestablishing corner:
- Found 1/2" rod and accessories at intersection of Castle and Edward Roads
- Accepted 1/2" rod as marking original corner

- C. Description of monument for corner and accessories established to perpetuate locating the position of the corner:
- Removed 1/2" iron and replaced with Standard Tuscola County Concrete Monument w/ 2" Brass Cap stamped I13 T10N R9E
 - N20°E, 74.93'-T.C. Re-mon. tag in West face of 24" Maple
 - N80°E, 123.65'-T.C. Re-mon. tag in West face 24" Elm
 - S20°W, 29.44' -T.C. Re-mon. tag in East face of Guy Pole
 - N70°W, 121.58' -T.C. Re-mon. tag in North face of Pwr. Pole

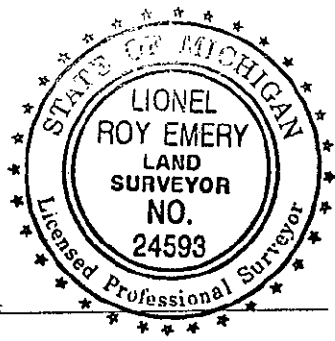

Signed by Lionel Roy Emery
Surveyor's Michigan License No. 24593

Date October 4, 1994

APPROVED
7-11-94

Handwritten initials and date:
2500
G.M.G.
J.M.F.

984 (Survey - Liber 541, page 1468) Harold Elrich, P.S. 18986 -found 2" iron-N20°E, 73.75'-
 Spike in 24" Maple; N45°W, 34.43'-nail/tag in cor. post; S15°W, 29.28'-nail/tag in pwr. pole

