5. Private Claims

OCT 2 0 1994

COMMISSION


1994 REMONUMENTATION PROGRAM LAND CORNER RECORDATION CERTIFICATE

Filing Requireme	nt of Ac	t 74.	Mich.	P.A.	1970

Fo	r corners in WATERT	OWN TOWNSHIP	ŕ	
	TUSCOLA (County)	Located In:	Corner Code ##	CEIV DERI OCT OCT GISINI
1.	Public Land Survey	T <u>10N</u> R <u>9E</u> T R T R	<u>L-13</u>	HO PA HO PA HO PA HO PA HA M. MCL OLA COUL
	Property Controlling in Section	T R S T R S T R		AGE HO_ AGE HO_ ID: 34 LAREN EEDS
3.	Miscellaneous Property in Sec.	S T R S T R		Register of Deeds Stamp & File Number

I, Lionel Roy Emery in a field survey on May 18 do hereby certify that under requirements of P.A. 74, Michigan P.A. of 1970, the corner points mentioned in lines 1 and 2 above were in conformance with regulations and rules therefore as required in the current manual of survey instructions of the United States Department of the Interior, Bureau of Land Management or by a decree of a Court of Law and/or that the corner points mentioned in lines 3, 4 and 5 above were in conformance with the rules of the Michigan Board of Land Surveyors or by a Decree of a Court of Law; established, re-established, monumented, re-monumented, recovered, found as

NOTE: Not more than 4 corners, all in the same town and range, may be recorded on this certificate.

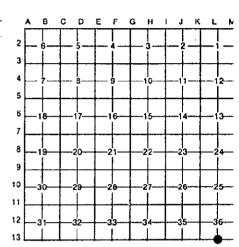

A. Description of original monument and accessories and/or subsequent restoration:

1834 (Gov't. Land Office Notes) Harvey Parke, D.S. -set quarter Section post- Beech 8 N57W 27; W. Ash 8 N675E 20

1972/1973 (Surveys- Liber 2, page 128 and Liber 433, pages 10-15 also witness card) David Rowe, P.S. 11192 $-\frac{1}{2}$ " re-rod - West, 65.03'- N_2 cor. Sec. 1, Marathon Twp., Lapeer County, S60°E, 68.62'-nail in 15" tree; N35°W, 43.77' TP

1976 (Rowe Engineering Survey- Job No. C-1904-76) indicates S_2^1 cor. of Sec. 36, T10N-R9E -no accessories given

1979 (Survey, Liber 500, pages 454 and 455) James Beck, P.S. 21559 -found plow point -N45°W, 40.5'-spike/flag in PP; S45°E, 71.28'-spike/flag in 14" Walnut tree; S45°W, 65.58'-14" Popl 1988 (Survey, Liber 585, page 1465) Earl Gravlin, P.S. 23510 -fnd. plow pt.- same accessories as B. Description of corner evidence found and/or method applied in restoring or reestablishing corner:

Beck's above

Found 1/2" re-rod and accessories as indicated on Rowe's Surveys

Accepted 2" re-rod as marking original corner

__ , Recorded Plat

C. Description of monument for corner and accessories established to perpetuate locating the position of the corner: Removed 2" re-rod and replaced with Standard Tuscola County Concrete Monument w/ 2" Brass Cap stamped L13 T10N R9E

N25°E, 64.76'-T.C. Re-mon. tag in NW face 14" Elm

S55°E, 68.74'-T.C. Re-mon. tag in SW face 20" Black Walnut tree S35°E, 47.08'-T.C. Re-mon. tag in SW face 10" Elmina


S55°W, 65.79'-T.C. Re-mon. tag in SE face 24" Poplar

Date October 4, 1994

Surveyor's Michigan License No

FORM APPROVED BY MICHIGAN STATE BOARD OF LAND SURVEYORS, JAN. 28, 1971 REVISED JAN., 1983

LIONEI ROY EMERY AND SURVEYOR NO. 24593

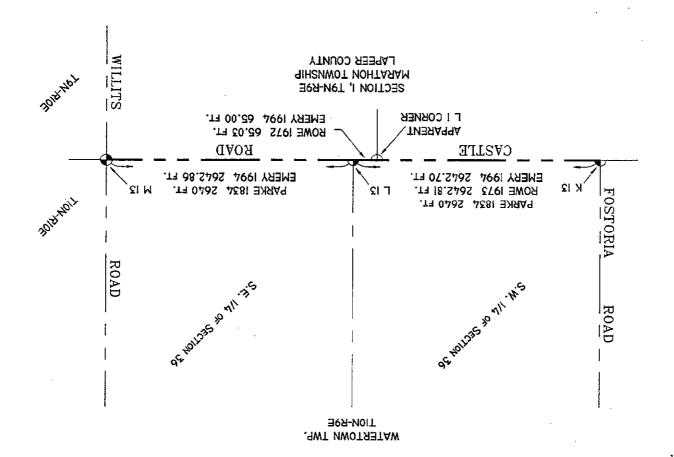

NO SCALE

. 1

- •{ '.

*.

