

OCT 20 1994

COMMISSION

LAND CORNER RECORDATION CERTIFICATE

Filing Requirement of Act 74, Mich. P.A. 1970
1994 REMONUMENTATION PROGRAM

For corners in Watertown Twp.
TUSCOLA
(County)

Located In:

Corner Code #

VIRGINIA H. MCLAREN
TUSCOLA COUNTY
REGISTER OF DEEDS

RECEIVED FOR RECORD
LIBER NO. _____ PAGE NO. _____
FILING NO. # 57
WATER TOWN Twp
94 OCT 10 AM 8:47
Register of Deeds Stamp & File Number

COPY

1. Public Land Survey	T 10N R 09E	M-1
	T _____ R _____	_____
	T _____ R _____	_____
	T _____ R _____	_____
2. Property Controlling in Section	S _____ T _____ R _____	_____
	S _____ T _____ R _____	_____
3. Miscellaneous Property in Sec.	S _____ T _____ R _____	_____
	S _____ T _____ R _____	_____

4. Lot No. _____, Recorded Plat _____
5. Private Claims _____

1	A	B	C	D	E	F	G	H	I	J	K	L	M
2	6	5	4	3	2	1							
3													
4	7	8	9	10	11	12							
5													
6	18	17	16	15	14	13							
7													
8	19	20	21	22	23	24							
9													
10	30	29	28	27	26	25							
11													
12	31	32	33	34	35	36							
13													

I, JONATHAN M. FIELD, in a field survey on JULY 17 19 94
do hereby certify that under requirements of P.A. 74, Michigan P.A. of 1970, the corner points mentioned in lines 1 and 2 above were in conformance with regulations and rules therefore as required in the current manual of survey instructions of the United States Department of the Interior, Bureau of Land Management or by a decree of a Court of Law and/or that the corner points mentioned in lines 3, 4 and 5 above were in conformance with the rules of the Michigan Board of Land Surveyors or by a Decree of a Court of Law; established, re-established, monumented, re-monumented, recovered, found as expressed below:

NOTE: Not more than 4 corners, all in the same town and range, may be recorded on this certificate.

A. Description of original monument and accessories and/or subsequent restoration:
1834 GLO; PARKE, D.S.; SET POST; BEECH 15 S34W 20LKS., BEECH 15 S57E 10LKS.


B. Description of corner evidence found and/or method applied in restoring or reestablishing corner:
1994 ROWE ENG. - FIELD, P.S.#37276; FND NO EVIDENCE OF MONUMENT AT CORNER

ESTABLISHED CORNER POSITION BY INTERSECTION OF LINE BETWEEN K-13 AND L-13, T11N-R9E WITH LINE FROM M-3, T10N-R9E PROJECTED NORTH THROUGH M-2, T10N-R9E

SEE ALSO BACK OF THIS FORM

C. Description of monument for corner and accessories established to perpetuate localing the position of the corner:
M-1 SET STANDARD MONUMENT (5/8"X36" ROD W/BRASS CAP IN CONC., IN MON BOX)

- N73°W, 8.23' SET 60d NAIL W/ FLAGGING
- S49°E, 70.44' SET NAIL W/REMON TAG IN SW FACE T. POLE
- S42°W, 47.41' SET CHIS. NOTCH IN TOP CENTER S. END 30" C.S.P.
- N46°W, 35.71' SET CHIS. NOTCH IN TOP CENTER N. END 30" C.S.P.
- N26°E, 21.91' SET CHIS. NOTCH IN E. EDGE OF E. SIGN POST LEG
- NORTH 1' C/L ASPH. ROAD E-W
- EAST 3.5' C/L GRAVEL ROAD S.

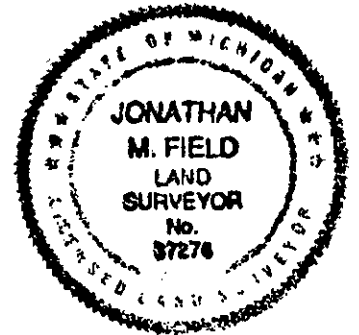

Signed by Jonathan M. Field Date 9-2-94
Surveyor's Michigan License No. 37276

APPROVED
8-31-94

Handwritten signature/initials

