

OCT 20 1994

COMMISSION

LAND CORNER RECORDATION CERTIFICATE

Filing Requirement of Act 74, Mich. P.A. 1970
1994 REMONUMENTATION PROGRAM

RECEIVED FOR RECORD
LIBER NO. _____ PAGE NO. _____
FILMS NO. # 62
WATERTOWN TWP.
94 OCT 10 AM 8:47
VIRGINIA H. HOLLAND
TUSCOLA COUNTY
REGISTER OF DEEDS

For corners in Watertown Twp.
TUSCOLA
(County)

Located In:

Corner Code #

COPY

1. Public Land Survey	T	10N	R	09E	M-6
	T		R		
	T		R		
	T		R		
2. Property Controlling in Section	S		T	R	
	S		T	R	
3. Miscellaneous Property in Sec.	S		T	R	
	S		T	R	

Register of Deeds Stamp & File Number

4. Lot No. _____, Recorded Plat _____
5. Private Claims _____

1	A	B	C	D	E	F	G	H	I	J	K	L	M
2	6	5	4	3	2	1							
3													
4	7	8	9	10	11	12							
5													
6	18	17	16	15	14	13							
7													
8	19	20	21	22	23	24							
9													
10	30	29	28	27	26	25							
11													
12	31	32	33	34	35	36							
13													

I, JONATHAN M. FIELD, in a field survey on JULY 17 19 94, do hereby certify that under requirements of P.A. 74, Michigan P.A. of 1970, the corner points mentioned in lines 1 and 2 above were in conformance with regulations and rules therefore as required in the current manual of survey instructions of the United States Department of the Interior, Bureau of Land Management or by a decree of a Court of Law and/or that the corner points mentioned in lines 3, 4 and 5 above were in conformance with the rules of the Michigan Board of Land Surveyors or by a Decree of a Court of Law; established, re-established, monumented, re-monumented, recovered, found as expressed below:

NOTE: Not more than 4 corners, all in the same town and range, may be recorded on this certificate.


A. Description of original monument and accessories and/or subsequent restoration:
1834 GLO; PARKE, D.S.; SET POST; BEECH 10 S78W 24LKS., BEECH 6 N28 1/2W 28LKS.
1989 GRAVLIN, P.S.#23510; LCRC L.004, PG.261; FND 1/2" IRON; EAST 21.27' NAIL IN 12" BOX ELDER S25°W 52.85' NAIL IN 6" BOX ELDER, WEST 3' C/L GRAVEL ROAD

B. Description of corner evidence found and/or method applied in restoring or reestablishing corner:
1994 ROWE ENG. - FIELD, P.S.#37276; FND 1/2" ROD 2' E. OF C/L GRAVEL ROAD N-S & ON LINE W/FENCE/TREE ROW TO E. 2 PREVIOUS WITNESSES INDICATE THAT 1/2" ROD IS IN SAME POSITION AS 1989 GRAVLIN IRON

ACCEPTED 1/2" ROD AS BEST EVIDENCE OF ORIGINAL CORNER POSITION

SEE ALSO BACK OF THIS FORM

C. Description of monument for corner and accessories established to perpetuate locating the position of the corner:
M-6 REMOVED 1/2" ROD, SET STANDARD MONUMENT (5/8"X36" ROD W/BRASS CAP IN CONC.)
S25°W, 52.77' FND NAIL W/FLAG IN E. FACE 12" ASH
N87°E, 21.03' SET NAIL W/REMON TAG IN N. FACE CLUMP ASH
N87°E, 47.25' SET NAIL W/REMON TAG IN N. FACE T. POLE
N81°W, 25.19' FND NAIL W/FLAG IN N. FACE 8" ELM
N28°W, 39.30' SET NAIL W/REMON TAG IN E. FACE 6" ELM

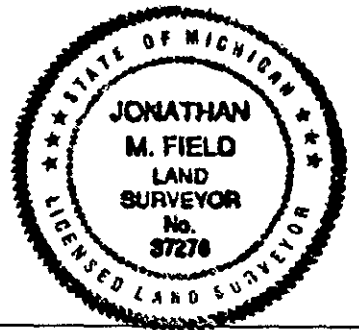

Signed by Jonathan M. Field Date 9-2-94

Surveyor's Michigan License No. 37276

APPROVED
2-31-94
J.M.F.

MURPHY LAKE ROAD



NE 1/4
SEC. 13
T10N-R9E

1834 GLO 2640'
1994 REI 2657.68'

M-5

179°59'41"

M-6

WILLITS ROAD

SE 1/4
SEC. 13
T10N-R9E

1834 GLO 2640'
1994 REI 2639.45'

MILLINGTON ROAD

179°58'39"

M-7

Handwritten signature or initials