

SUPPLY 2
REMONUMENTATION

OCT 20 1994

LAND CORNER RECORDATION CERTIFICATE

Filing Requirement of Act 74, Mich. P.A. 1970

1994 REMONUMENTATION PROGRAM

For corners in COMMISSION Watertown Twp.
TUSCOLA
(County)

Located In:

Corner Code #

COPY

VIRGINIA M. McLAUREN
TUSCOLA COUNTY
REGISTER OF DEEDS

94 OCT 10 AM 8:48
WATERTOWN TWP

RECEIVED FOR RECORD
LIBER NO. _____ PAGE NO. _____
FILING NO. #64

Register of Deeds Stamp & File Number

- 1. Public Land Survey T 10N R 09E M-8
- T _____ R _____
- T _____ R _____
- T _____ R _____
- T _____ R _____
- 2. Property Controlling S _____ T _____ R _____
- in Section S _____ T _____ R _____
- 3. Miscellaneous S _____ T _____ R _____
- Property in Sec. S _____ T _____ R _____

- 4. Lot No. _____, Recorded Plat _____
- 5. Private Claims _____

	A	B	C	D	E	F	G	H	I	J	K	L	M
1													
2	6	5	4	3	2	1							
3													
4	7	8	9	10	11	12							
5													
6	18	17	16	15	14	13							
7													
8	19	20	21	22	23	24							
9													
10	30	29	28	27	26	25							
11													
12	31	32	33	34	35	36							
13													

I, JONATHAN M. FIELD, in a field survey on JULY 17 19 94, do hereby certify that under requirements of P.A. 74, Michigan P.A. of 1970, the corner points mentioned in lines 1 and 2 above were in conformance with regulations and rules therefore as required in the current manual of survey instructions of the United States Department of the Interior, Bureau of Land Management or by a decree of a Court of Law and/or that the corner points mentioned in lines 3, 4 and 5 above were in conformance with the rules of the Michigan Board of Land Surveyors or by a Decree of a Court of Law; established, re-established, monumented, re-monumented, recovered, found as expressed below:

NOTE: Not more than 4 corners, all in the same town and range, may be recorded on this certificate.


- A. Description of original monument and accessories and/or subsequent restoration:
 1834 GLO; PARKE, D.S.; SET POST; LYNN 20 N42W 25LKS., W.ASH - S32W 35LKS.
 1974 COMMONWEALTH; SWARTS, P.S.#16945; SURVEY L.2, PG.958; SET 1/2" IRON; N15°W 112.82' P-K IN 24" STUMP, N80°E 49.24' P-K NAIL P.POLE, S30°E 66.73' P-K NAIL IN 24" STUMP
 1974 SWARTS, P.S.#16945; LCRC 23; SET 1/2" IRON ON LINE & MIDWAY BTWN NE & SE COR.; N80°E 49.24' NAIL IN P.POLE, S30°E 66.73' NAIL IN 24" STUMP, N15°W 112.82' NAIL IN 24" STUMP
 1988 DAVIS, P.S.#22430; LCRC L.004, PG.189; FND 1/2" IRON; EAST 25.48' P-K NAIL T.POLE, WEST 24.22' P-K NAIL 16" STUMP, S20°E 52.65' P-K NAIL 14" TREE, S30°W 43.10' P-K NAIL 28" TREE

- B. Description of corner evidence found and/or method applied in restoring or reestablishing corner:
 1994 ROWE ENG. - FIELD, P.S.#37276; FND NO EVIDENCE OF MONUMENT AT CORNER

RE-ESTABLISHED CORNER POSITION BY SINGLE PROPORTIONMENT BETWEEN M-7 AND M-9, T10N-R9E FIELD LINE TO W. BRUSH ROW TO E.

SEE ALSO BACK OF THIS FORM

- C. Description of monument for corner and accessories established to perpetuate locating the position of the corner:
 M-8 SET STANDARD MONUMENT (5/8"X36"ROD W/ BRASS CAP IN CONC.)
 S41°W, 6.64' SET 1/2" ROD
 S29°E, 58.42' SET NAIL W/REMON TAG IN W. FACE 10" ELM
 N86°E, 48.39' SET NAIL W/REMON TAG ABOVE FND P-K NAIL IN W. FACE P.POLE
 S49°W, 15.78' SET CHIS. NOTCH IN TOP CENTER W. END 12" CSP
 S61°E, 20.73' SET CHIS. NOTCH IN TOP CENTER E. END 12" CSP
 EAST, 5.5' C/L OF GRAVEL ROAD N-S

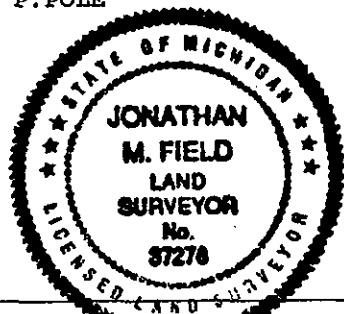

Signed by Jonathan M. Field Date 9-2-94
 Surveyor's Michigan License No. 37276

APPROVED
9-31-94
 J.M.F.
 J.P.C.

MILLINGTON ROAD

M-7

NE 1/4
SEC. 24
TION-R9E

1834 GLO 2640'
1994 REI 2645.50'

180°00'00"

M-8

SE 1/4
SEC. 24
TION-R9E

1834 GLO 2640'
1994 REI 2645.50'

BARNES ROAD

180°04'33"

M-9

WILLITS ROAD

