

OCT 20 1994

LAND CORNER RECORDATION CERTIFICATE

Filing Requirement of Act 74, Mich. P.A. 1970

COMMISSION

1994 REMONUMENTATION PROGRAM

For corners in Watertown Twp.
TUSCOLA
(County)

Located in:

Corner Code #

- 1. Public Land Survey T 10N R 09E M-12
- T _____ R _____
- T _____ R _____
- T _____ R _____
- 2. Property Controlling S _____ R _____
- in Section S _____ T _____ R _____
- 3. Miscellaneous S _____ T _____ R _____
- Property in Sec. S _____ T _____ R _____

Register of Deeds Stamp & File Number

RECEIVED FOR RECORDING
 LIBER NO. _____ PAGE NO. _____
 FILING NO. #68
WATERTOWN TWP.
 94 OCT 10 AM 8:48
 VIRGINIA H. HOLLAND
 TUSCOLA COUNTY
 REGISTER OF DEEDS

- 4. Lot No. _____, Recorded Plat _____
- 5. Private Claims _____

| | A | B | C | D | E | F | G | H | I | J | K | L | |
|----|----|---|----|---|----|---|----|---|----|---|----|---|--|
| 1 | | | | | | | | | | | | | |
| 2 | 6 | | 5 | | 4 | | 3 | | 2 | | 1 | | |
| 3 | | | | | | | | | | | | | |
| 4 | 7 | | 8 | | 9 | | 10 | | 11 | | 12 | | |
| 5 | | | | | | | | | | | | | |
| 6 | 18 | | 17 | | 16 | | 15 | | 14 | | 13 | | |
| 7 | | | | | | | | | | | | | |
| 8 | 19 | | 20 | | 21 | | 22 | | 23 | | 24 | | |
| 9 | | | | | | | | | | | | | |
| 10 | 30 | | 29 | | 28 | | 27 | | 26 | | 25 | | |
| 11 | | | | | | | | | | | | | |
| 12 | 31 | | 32 | | 33 | | 34 | | 35 | | 36 | | |

I, JONATHAN M. FIELD, in a field survey on JULY 17 19 94, do hereby certify that under requirements of P.A. 74, Michigan P.A. of 1970, the corner points mentioned in lines 1 and 2 above were in conformance with regulations and rules therefore as required in the current manual of survey instructions of the United States Department of the Interior, Bureau of Land Management, or by a decree of a Court of Law and/or that the corner points mentioned in lines 3, 4 and 5 above were in conformance with the rules of the Michigan Board of Land Surveyors or by a Decree of a Court of Law; established, re-established, monumented, re-monumented, recovered, found as expressed below:

NOTE: Not more than 4 corners, all in the same town and range, may be recorded on this certificate.

- A. Description of original monument and accessories and/or subsequent restoration:
 1834 GLO; PARKE, D.S.; SET POST; MAPLE 12 S32W 46LKS., HEMLOCK 12 N44 1/2W 37 1/2LKS.
 1892 FELTON, C.S.; PREV SET STONE & IRON AT COR.; ELM 4 N58 1/4W 77LKS.
 1979 BECK-GRAVLIN; BECK, P.S.#21559; SURVEY L.500, PG.454-455; FND IRON; N60°E 28.42' NAIL 20" STUMP, N45°W 40.20' NAIL 6" ELM, S45°W 35.75' NAIL 6" FE POST
 1988 GRAVLIN, P.S.#23510; SURVEY L.585, PG.1465; FND IRON; WITS SAME AS 1979 SURVEY ABOVE
 1989 GRAVLIN SURVEYING; GRAVLIN, P.S.#23510; SURVEY L.008, PG.546; FND 5/8" IRON; EAST 21.55' 10" ELM, N70°E 58.81' 8" ELM, S80°W 16.32' 6" ASH
 1991: GRAVLIN, P.S.#23510; LCRC L.004, PG.375; FND 5/8" IRON; WITS SAME AS 1989 SURVEY ABOVE
 1991 GRAVLIN, P.S.#23510; LCRC L.004, PG.381; FND 5/8" IRON; WITS SAME AS 1989 SURVEY ABOVE
- B. Description of corner evidence found and/or method applied in restoring or reestablishing corner:
 1994 ROWE ENG. - FIELD, P.S.#37276; FND 5/8" ROD 2' W. OF C/L GRAVEL ROAD N-S & ON LINE W/TREE ROW E-W 1 PREVIOUS WITNESS INDICATES THAT 5/8" ROD IS IN SAME POSITION AS 1979 BECK-GRAVLIN IRON


ACCEPTED 5/8" ROD AS BEST EVIDENCE OF ORIGINAL CORNER POSITION

SEE ALSO BACK OF THIS FORM

- C. Description of monument for corner and accessories established to perpetuate locating the position of the corner:
 M-12 REMOVED ROD, SET STANDARD MONUMENT (5/8"X36" ROD W/BRASS CAP IN CONC.)
 N67°E, 29.25' SET NAIL W/REMON TAG IN NW FACE 24" STUMP (FND NAIL W/FLAG IN SW FACE)
 S88°E, 21.61' SET NAIL W/REMON TAG ABOVE FND NAIL W/FLAG IN N. FACE 12" ELM
 S65°W, 16.35' SET NAIL W/REMON TAG ABOVE FND NAIL W/FLAG IN S. FACE 8" ASH
 S89°W, 32.96' FND 1/2" ROD
 N40°W, 18.85' SET NAIL W/REMON TAG IN NE FACE 8" ASH

Signed by Jonathan M. Field Date 9-2-94
 Surveyor's Michigan License No. 37276

APPROVED
3-31-94
 JMO
 J.P.B.

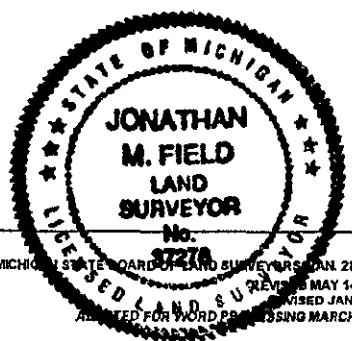

GOODRICH ROAD



NE 1/4

1834 GLO 2640'
1892 FELTON 2643.30'
1989 GRAVLIN 2643.08'
1994 REI 2642.92'

SEC. 36
T10N-R9E

180° 5' 04"

M-11

M-12

WILLITS ROAD

SE 1/4

1834 GLO 2640'
1892 FELTON 2643.30'
1979 GRAVLIN 2645.63'
1994 REI 2645.24'

~~BROWN ROAD~~

M-13

COBY