

**SURVEY &
REMONUMENTATION**

APR 25 1995

LAND CORNER RECORDATION CERTIFICATE

COMMISSION

Filing Requirement of Act 74, Mich. P.A. 1970
1994 REMONUMENTATION PROGRAM

COPY

RECEIVED FOR RECORD
LIBER NO. _____ PAGE NO. _____
FILING NO. #54
TUSCOLA TWP
94 NOV 15 AM 10:25
VIRGINIA H. McLAGLEN
TUSCOLA COUNTY
REGISTER OF DEEDS

For corners in TUSCOLA TWP.
TUSCOLA
(County)

Located in:

Corner Code #

- | | | | | | |
|------------------------------------|---|-----|---|-----|------|
| 1. Public Land Survey | T | 11N | R | 07E | A-13 |
| | T | | R | | |
| | T | | R | | |
| | T | | R | | |
| 2. Property Controlling in Section | S | T | R | | |
| | S | T | R | | |
| 3. Miscellaneous Property in Sec. | S | T | R | | |
| | S | T | R | | |

Register of Deeds Stamp & File Number

4. Lot No. _____, Recorded Plat _____
5. Private Claims _____

	A	B	C	D	E	F	G	H	I	J	K	L
1												
2	6	5	4	3	2	1						
3												
4	7	8	9	10	11	12						
5												
6	18	17	16	15	14	13						
7												
8	19	20	21	22	23	24						
9												
10	30	29	28	27	26	25						
11												
12	31	32	33	34	35	36						
13												

I, JONATHAN M. FIELD, in a field survey on AUGUST 5 19 94
do hereby certify that under requirements of P.A. 74, Michigan P.A. of 1970, the corner points mentioned in lines 1 and 2 above were in conformance with regulations and rules therefore as required in the current manual of survey instructions of the United States Department of the Interior, Bureau of Land Management or by a decree of a Court of Law and/or that the corner points mentioned in lines 3, 4 and 5 above were in conformance with the rules of the Michigan Board of Land Surveyors or by a Decree of a Court of Law; established, re-established, monumented, re-monumented, recovered, found as expressed below:

NOTE: Not more than 4 corners, all in the same town and range, may be recorded on this certificate.

A. Description of original monument and accessories and/or subsequent restoration:

- 1821 GLO; WAMPLER, D.S.; SET POST; BIRCH 30 N35E 2LKS., MAPLE 7 S13E 29LKS.
- 1968 CPCO; BOLDT; FND 1" ROD; NW 38.44' RD SIGN, SE 59.39 POLE, SW 74.84' POLE
- 1978 PREVOST, P.S.#24612; LCRC 38; FND T-IRON; N45°W 38.64' FACE T.POLE, N44°W 38.10' CTR RD SIGN POST, S45°W 74.52' FACE P.POLE, S40°E 58.97' FACE P.POLE, S45°E 43.03 CTR RD SIGN POST
- 1980 SPICER ENG.; MARTIN, P.S.#4699; SURVEY L.505, PG.132-133; T-IRON; SAME WITS AS 1978 LCRC
- 1981 DUNTON SURVEYING; DUNTON, P.S.#23503; SURVEY L.515, PG.940-941; NO OBJECT STATED; DIST. OF 852.04' TO B-13


B. Description of corner evidence found and/or method applied in restoring or reestablishing corner:

- 1994 ROWE ENG. - FIELD, P.S.#37276; FND T-IRON AT C/L-C/L OF ROADS N-S-E-W
- FND. 3 PREVIOUS WITS INDICATING T-IRON IS IN SAME POSITION AS 1968 1" ROD
- ACCEPTED T-IRON AS BEST EVIDENCE OF ORIGINAL CORNER POSITION

SEE ALSO BACK OF THIS FORM

C. Description of monument for corner and accessories established to perpetuate locating the position of the corner:

- A-13 REMOVED T-IRON, SET STANDARD MONUMENT (5/8"X36" ROD W/ BRASS CAP IN CONC.) IN MON. BOX
- N49°E, 30.15' SET 1/2" ROD
- S29°E, 35.12' CENTER OF ROAD SIGN POST
- S32°E, 59.43' FND. NAIL W/DISK IN SW FACE P.POLE
- S47°W, 74.05' FND. NAIL W/DISK IN NW FACE P.POLE
- S47°W, 74.86' CENTER OF CUT-OFF P.POLE
- N50°W, 38.78' FND. NAIL W/DISK IN ENE FACE CUT-OFF P.POLE
- N43°W, 38.41' CENTER OF ROAD SIGN POST

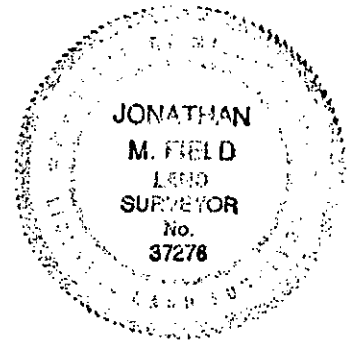

Signed by Jonathan M. Field

Date 11-4-94

Surveyor's Michigan License No. 37276

APPROVED
10-24-94
J. M. Field

