

# SURVEY & REMONUMENTATION

APR 25 1995

## COMMISSION

### LAND CORNER RECORDATION CERTIFICATE

Filing Requirement of Act 74, Mich. P.A. 1970  
1994 REMONUMENTATION PROGRAM

COPY

RECEIVED FOR RECORD  
LIBER NO. \_\_\_\_\_ PAGE NO. \_\_\_\_\_  
FILMS NO. # 55  
TUSCOLA TWP  
94 NOV 15 AM 10:25  
VIRGINIA M. McLAGEN  
TUSCOLA COUNTY  
REGISTER OF DEEDS

For corners in <u>TUSCOLA TWP.</u> <small>(County)</small>	Located In:	Corner Code #
1. Public Land Survey	T <u>11N</u> R <u>07E</u>	<u>B-13</u>
	T _____ R _____	_____
	T _____ R _____	_____
	T _____ R _____	_____
2. Property Controlling in Section	S _____ T _____ R _____	_____
	S _____ T _____ R _____	_____
3. Miscellaneous Property in Sec.	S _____ T _____ R _____	_____
	S _____ T _____ R _____	_____

Register of Deeds Stamp & File Number

4. Lot No. \_\_\_\_\_, Recorded Plat \_\_\_\_\_  
5. Private Claims \_\_\_\_\_

1	A	B	C	D	E	F	G	H	I	J	K	L
2	6	5	4	3	2	1						
3												
4	7	8	9	10	11	12						
5												
6	18	17	16	15	14	13						
7												
8	19	20	21	22	23	24						
9												
10	30	29	28	27	26	25						
11												
12	31	32	33	34	35	36						
13												

I, JONATHAN M. FIELD, in a field survey on AUGUST 5 19 94, do hereby certify that under requirements of P.A. 74, Michigan P.A. of 1970, the corner points mentioned in lines 1 and 2 above were in conformance with regulations and rules therefore as required in the current manual of survey instructions of the United States Department of the Interior, Bureau of Land Management or by a decree of a Court of Law and/or that the corner points mentioned in lines 3, 4 and 5 above were in conformance with the rules of the Michigan Board of Land Surveyors or by a Decree of a Court of Law; established, re-established, monumented, re-monumented, recovered, found as expressed below:


**NOTE: Not more than 4 corners, all in the same town and range, may be recorded on this certificate.**

A. Description of original monument and accessories and/or subsequent restoration:  
 1821 GLO; WAMPLER, D.S.; SET POST; BEECH 22 S83E 26LKS., SUGAR 9 S53W 34LKS.  
 1968 CPCO; BOLDT; SURVEY OF SEC.31; NO OBJECT SHOWN,; NO WITS GIVEN  
 1979 DUNTON, P.S.#23503; LCRC 47; FND. P-K NAIL - SET 1/2" ROD; N. 3' C/L PVMNT., N10°E 37.5' 4" PIPE 24" HIGH, E. 329.98' 3/4" PIPE @ C/L TOWER LINES  
 1981 DUNTON SURVEYING; DUNTON, P.S.#23503; SURVEY L.515, PG.940-941; FND P-K NAIL - SET 1/2" ROD; N15°W 51.4' P-K IN P.POLE, S10°E 33.1' P-K IN P.POLE, EAST 329.98' 3/4" PIPE @ C/L TOWER LINE, N. 3' C/L PVMT.

B. Description of corner evidence found and/or method applied in restoring or reestablishing corner:  
 1994 ROWE ENG.; FIELD, P.S.#37276; FND. 1/2" ROD 3' S. OF C/L ASPH ROAD E-W  
 FND. 2 PREVIOUS WITS. INDICATING THAT 1/2" ROD IS IN SAME POSITION AS 1979 ROD  
 ACCEPTED FND. 1/2" ROD AS BEST EVIDENCE OF ORIGINAL CORNER POSITION

SEE ALSO BACK OF THIS FORM

C. Description of monument for corner and accessories established to perpetuate locating the position of the corner:  
 B-13 REMOVED 1/2" ROD, SET STANDARD MONUMENT (5/8" X 36" ROD W/ BRASS CAP IN CONC.) IN MON. BOX  
 N29°W, 33.03' FND. P-K NAIL IN E. FACE P.POLE  
 N26°W, 37.77' TOP CENTER OF 4" STEEL PIPE  
 S14°E, 51.25' FND. P-K NAIL IN NE FACE P.POLE  
 S70°W, 26.57' SET 1/2" ROD  
 N62°E, 36.59' SET 1/2" ROD  
 EAST 330'+/- CENTER OF POWER TRANSMISSION TOWERS N-S

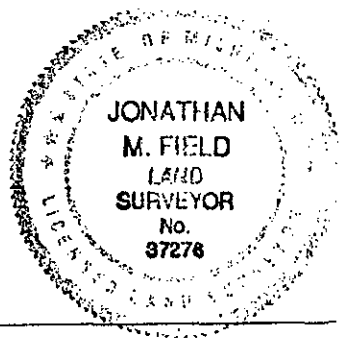

Signed by Jonathan M. Field Date 11-4-94  
 Surveyor's Michigan License No. 37276

**APPROVED**  
11-24-94  
*[Signature]*

