SURVEY & REMONUMENTATION

APR 2 5 1995

Court of Law;

expressed below:

on this certificate.

LAND CORNER RECORDATION CERTIFICATE

COMMISSION

Filing Requirement of Act 74, Mich. P.A. 1970

•	1994	REMONUMENTATION PROG		≥. ود	治ノヨ	
For corners in TUSCOLA TWP.	Located In:	Corner Code #	KAM	2000 1900 1900 1900 1900 1900 1900 1900	150 E	BE LE
(County)					A 12 2077 3 HO.	HO.
Public Land Survey	T_11N_R_07E TR TR	C-13		COUNTY COUNTY OF OFEOS	# 56 1767 AH 10: 2	- OR RECO
2. Property Controlling S S	T R			Service and the service and th	0,0	
3. Miscellaneous S Property in Sec. S	T R R T R		Register of De	eds Stamp	& File Num	ber
4. Lot No, Recorded 5. Private Claims	Plat		1 A B C	DEF	9 ніј	K L
			2 -6.	5 4	3 - 2	1
do hereby certify that under requirement	nts of P.A. 74, Michigan P	AUGUST 5 19 2.A. of 1970, the corner points mention	ned	8 9	. 10 - 11	. 12
In lines 1 and 2 above were in confor current manual of survey instructions of Management or by a decree of a Court of	of the United States Depa of Law and/or that the cor	artment of the Interior, Bureau of La rner points mentioned in lines 3, 4 an	the and 6 18 and 5 7	17 16	15 14	13
above were in conformance with the ru	les of the Michigan Board	d of Land Surveyors or by a Decree o	ofa I I		:	i

Description of original monument and accessories and/or subsequent restoration:

NOTE: Not more than 4 corners, all in the same town and range, may be recorded

- 1821 GLO; WAMPLER, D.S.; SET POST; BEECH 9 N67E 27LKS., MAPLE 21 S62W 25LKS.
- 1968 CPCO; BOLDT; SURVEY OF SEC.31; NO OBJECT SHOWN; NO WITS STATED

established, re-established, monumented, re-monumented, recovered, found as

- 1974 ROWE ENG; ROWE, P.S.#11192; SURVEY L.445,PG.754; 1/2" PIPE; N55°W 45.1' 6" PINE, N30°E 45.81' TAG #11192 IN T.POLE, S40°E 80.88' TAG #11192 IN P.POLE
- 1976 CONSULTING ENG.; ROWE ENG. WIT CARD; FND. PIPE 2.7'S. OF C/L RD; S52°E 44.6' FACE T.POLE S61°W 90.15' NAIL W/TAG P.POLE, N12°W, 90.5' FACE P.POLE 1978 PREVOST, P.S. #24612; LCRC 37; FND. 3/4" PIPE; S50°W 89.83' FACE P.POLE, S65°E 44.55' FACE
- T.POLE, N10°W 90.50' FACE T.POLE, N80°W 50.23' CTR RD SIGN POST 1980 SPICER ENG.; MARTIN, P.S.#4699; SURVEY L.505,PG.132-133; OBJECT NOT STATED, NO WITS
- GIVEN
- 1981 DUNTON SURVEYING; DUNTON, P.S.#23503; SURVEY L.515, PG.940-941; OBJECT NOT STATED, NO WITS GIVEN
- 1987 ROWE ENG.; BEDFORD; MORTGAGE REPORT REI JOB NO. C-4190-87; FND. 3/4" PIPE; NO WITS GIVEN
- Description of corner evidence found and/or method applied in restoring or reestablishing corner:
- 1994 ROWE ENG. FIELD, P.S.#37276; FND 3/4" PIPE 2.7' S. OF C/L ASPH. ROAD E-W & 2' W. OF C/L GRAVEL ROAD TO N. ALSO FND BELOW PIPE 1 1/4" IRON BAR 1.7' LONG W/ HORSESHOE AND STONES AROUND BASE FND. 2 PREVIOUS WITS. INDICATING THAT 3/4" PIPE IS IN SAME POSITION AS 1976 PIPE

ACCEPTED 3/4" PIPE AS BEST EVIDENCE OF ORIGINAL CORNER POSITION

SEE ALSO BACK OF THIS FORM

Description of monument for corner and accessories established to perpetuate locating the position of the corner:

C-13 REMOVED 3/4" PIPE, SET STANDARD MONUMENT (5/8"X36" ROD W/ BRASS CAP IN CONC.) IN MON. BOX

EAST, 152.81' FND. 3/4" PIPE

N50°W, 36.42' SET 1/2"ROD

N32°E, 38.28' SET 1/2" ROD

44.56' SET NAIL W/REMON TAG IN NE FACE CUT-OFF T.POLE \$57°E,

S57°W. 90.11' FND. NAIL W/DISK IN N. FACE P.POLE

N31°E, 170.07' SET NAIL W/REMON TAG IN SE FACE P.POLE

SL 3721 OFLAND SURI JONATHA

CUPY

19

30

8

10

11

12 31 20

20

32

28

33

22

27

34

23

26

35

24

25

36


Surveyor's Michigan License No. 37276

Date APPROVED

ORM APPROVED BY MICHIGAN STATE BOARD OF LAND SURVEYORS, JAN. 28, 19

ADAPTED FOR WORD PROCESSING MARCH, 16



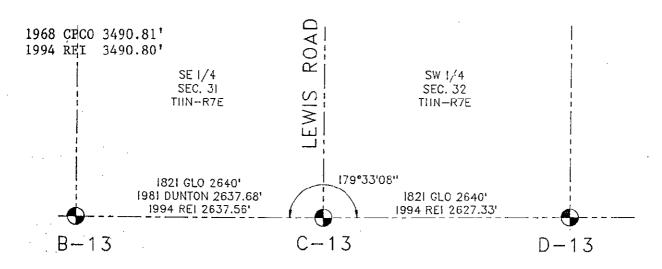

SWAFFER ROAD