## SURVEY & REMONUMENTATION



APR 2 5 1995

## LAND CORNER RECORDATION CERTIFICATE


Filing Requirement of Act 74, Mich. P.A. 1970

For corners in TUSCOLA TWP.	1994 KI	MUNUMENTATION PROGRAM			ြင်း	=6	EE ()	m m	m
TUSCOLA	Located In:	Corner Code #			<u>ن</u> ک	3==	98	ක් 🌫	EIVED
(County)	Locatou III.	00.110, 0040 //			<del>-</del> -13	955	_3	2 8 2 8	[7]
<b>,</b>					2012	> [7]	$2^{\circ}$		m444
					200	الوأو	7	#	် ဆို
Public Land Survey	T_11N_R_07E_	D-13			C16	D : jr	III.	ت ر	
	T R				ras		iol Hid	AGE 57	RECONS
	TR				::::-	₹39		111	8
	TR				S		38		50
2. Property Controlling S	T R	_					$\mathcal{J}$	i	<b>6</b> ., ,
in Section S	T R							i	
3. Miscellaneous S	TR		Registe	r of I	Deeds S	tamp	& File	Numbe	≥r
Property in Sec. S									
4. Lot No, Recorded	Plat		_ ,	<b>В</b>	C D	E F	G H I	JK	i. 1
5. Private Claims		,	_ ''		<del></del>	ī — ·	T		
			2	6	5	4	- <b>3</b>	2	1
			3				L	T	<u>.</u>
		GUIGH F 40 04		·					
, JONATHAN M. FIELD			. 4	7	8	9	10	11-	12
do hereby certify that under requirement			5	- :	<del>                                     </del>		- :		
in lines 1 and 2 above were in conformance with regulations and rules therefore as required in the current manual of survey instructions of the United States Department of the Interior, Bureau of Land				18	17	16	- 15	14-	13
Management or by a decree of a Court			6 7		1 1	1,7	LÌ.	:	
above were in conformance with the ru	ites of the Michigan Board of	Land Surveyors or by a Decree of a	-	10	00		1 100	00	n'a
Court of Law; established, re-esta	blished, monumented, re-m	onumented, recovered, found as	8	19	20	21	22	23	24
expressed below:			9		+		1		
		t control of	10	30	29	28	-27	26	25
NOTE: Not more than 4 corner	s, all in the same town	and range, may be recorded	11				<u> </u>		·
on this certificate.			12	31	32	33	34	35	36
			13	31	32	🏋	34	33	
A. Description of original monu	ment and accessories an	d/or subsequent restoration:	13			•			
1821 GLO: WAMPLER D S	HICKORY 8" AT	1/4 CORNER; NO WITS GIV	EN						
B. Description of corner evidence	ce found and/or method a	pplied in restoring or reestablishing	g corner	`; ** *	יו מגטי	_W C	OM E	TELD	
		RR SPIKE 6.3' S. OF C/	L ASP	д. 1	KOND E	-W &	ON E	7.171	
DIVISION LINE TO	И.								
· · · · · · · · · · · · · · · · · · ·		ON ONTOTALLY CONTENT DOO	THICK						
ACCEPTED FND. RR SPIKE	: AS BEST EVIDENCE	OF ORIGINAL CORNER POS	TITON						
								1	
								ř	
•									
SEE ALSO BACK OF THIS							•		
C Description of manument for	r comer and accessories	established to perpetuate locating t	he posi	tion c	f the co.	rner:			

D-13 REMOVED RR SPIKE, SET STANDARD MONUMENT (5/8"X 36" ROD W/ BRASS CAP IN CONC. IN MON BOX)

EAST, 57.17' FND. RR SPIKE EAST, 57.17' FND. RR SPIKE

N24°E, 31.92' SET CHIS. NOTCH IN TOP W. END 18" CSP

N56°E, 52.24' SET CHIS. NOTCH IN TOP E. END 18" CSP S14°E, 37.41' SET CHIS. NOTCH IN TOP E. END 12" CSP S35°E, 22.22' SET CHIS. NOTCH IN TOP W. END 12" CSP


LAND SURVEYOR

Date

Surveyor's Michigan License No. 37276

FORM APPROVED BY MICHIGAN STATE BOARD OF LAND SURVEYORS, JAN. 28, 19. REVISED MAY 14, 19
REVISED JAN., 19
REVISED JAN., 19
ADAPTED FOR WORD PROCESSING MARCH, 19



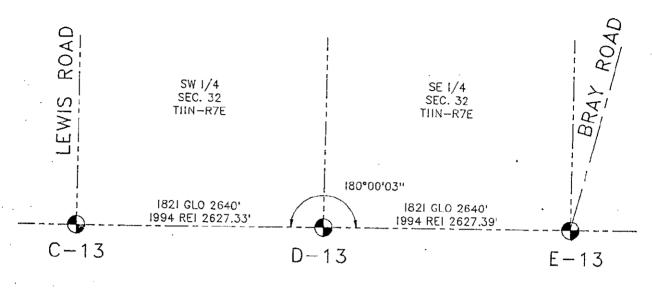

SWAFFER ROAD