SURVEY & REMONUMENTATION

APR 2 5 1995

COMMISSION


LAND CORNER RECORDATION CERTIFICATE

Filing Requirement of Act 74, Mich. P.A. 1970 1994 REMONUMENTATION PROGRAM

COPY

or corners in TUSCOLA TWP.	Located In:	Corner Code #	GRAM		85018 100			2281 13051
(County)					STER	(音) V (音) V (5) V (7)	$\mathcal{C}_{\mathcal{Z}}$	3 6
Public Land Survey	T 11N R 07E T R T R T R	F-13			OF DEED	H. S. O.	H 59	FOR RECON.
2. Property Controlling S in Section S 3. Miscellaneous S	T R T R		Registe	r of De	eeds S	tamp & F	110	•
Property in Sec. S	TR						~~~~~~~~~~~~~~~~~~~~~~~~~~~~~~~~~~~~~~	
4. Lot No, Recorded 5. Private Claims	Plat		1 /	В (C D E	FG	HIJ	K L
			2 3	6	5	4	3 2	· · 1
JONATHAN M. FIELD	, in a field survey on	AUGUST 5 19	94 . 4	7	-8	Q 1	0 11	12
to hereby certify that under requirement in lines 1 and 2 above were in conforturent manual of survey instructions of	mance with regulations a of the United States Depar	ind rules therefore as required in rtment of the Interior, Bureau of L	the and 6	18	17	16 1	5 14	13
Management or by a decree of a Court of bove were in conformance with the ru- court of Law; established, re-esta	of Law and/or that the corr des of the Michigan Board	ner points mentioned in lines 3, 4 au Lof Land Surveyors or by a Decree	nd 5 7 of a as 8	19	20	21 2	2 23	24
xpressed below: VOTE: Not more than 4 corner	s all in the same tow	m and range, may be record	9 10	30	29	28 2	7 26	25
on this certificate.	o, an in the same ton		11	31	32	33 3	4 36	36
MARK NE LEG TOWER 1971 ROWE ENG.; ROWE, 1988 BROWN, P.S.#33134 SAME WITS AS 1971	@ F-1 T10N-R7E, &, \$30°W 63.62' C P.S.#11192; SUR ### CARD CT REI WIT CARD CT ce found and/or method P.S.#37276; FN	T-IRON FLAT - SET 1 ITED ABOVE d applied in restoring or reesta D 1/2" ROD W/CAP #20	MARK NW LEC WER, N. 31. T-IRON; SAN /2" ROD W/G	F TOW O' F ME WI CAP #	TER, S TE COF (TS AS \$20709	440°W 4' R. POST B WIT C B FROM	7.22 ARD A	CHIS BOVE
						:		
F-13 REMOVED 1/2" ROD, WEST, 26.19' FN S57°W, 47.58' SE S54°W, 62.09' FN S40°W, 47.22' FN S28°W, 63.63' FN	r corner and accessorie SET STANDARD M ND. 1/2" PIPE T CHIS. NOTCH IN TD. CHIS. NOTCH IN TD. CHIS. NOTCH IN TD. CHIS. NOTCH IN TD. CHIS. NOTCH IN	es established to perpetuate to CONUMENT (5/8"X 36" R N TOP S. END 18" CSP IN NW LEG OF POWER TO IN NE LEG OF POWER TO IN SE LEG OF POWER TO N TOP N. END 18" CSP	od W/BRASS ower ower	CAP	the cor. IN CO	ONC.)	D i	
4					· Sonnage			
Signed by Junta 1.	24nl	Date	-4.94					
Surveyør's Michigan License No.	37276 <u>A</u>	PPROVED /SAG	FORM APPROVED	BY MICHIG	N STATE B	CARD OF LAND	SURVEYORS,	JAN. 26, 1



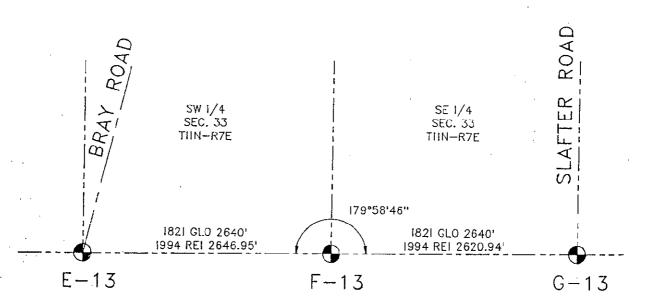

