

**SURVEY &
REMONUMENTATION**

APR 25 1995

COMMISSION

LAND CORNER RECORDATION CERTIFICATE

Filing Requirement of Act 74, Mich. P.A. 1970
1994 REMONUMENTATION PROGRAM

For corners in TUSCOLA TWP.
TUSCOLA
(County)

Located In:

Corner Code #

- | | | |
|------------------------------------|-------------|------|
| 1. Public Land Survey | T 11N R 07E | G-13 |
| | T R | |
| | T R | |
| | T R | |
| 2. Property Controlling in Section | S T R | |
| | S T R | |
| 3. Miscellaneous Property in Sec. | S T R | |
| | S T R | |

4. Lot No. _____, Recorded Plat _____
5. Private Claims _____

I, JONATHAN M. FIELD, in a field survey on AUGUST 5 19 94, do hereby certify that under requirements of P.A. 74, Michigan P.A. of 1970, the corner points mentioned in lines 1 and 2 above were in conformance with regulations and rules therefore as required in the current manual of survey instructions of the United States Department of the Interior, Bureau of Land Management or by a decree of a Court of Law and/or that the corner points mentioned in lines 3, 4 and 5 above were in conformance with the rules of the Michigan Board of Land Surveyors or by a Decree of a Court of Law; established, re-established, monumented, re-monumented, recovered, found as expressed below:

NOTE: Not more than 4 corners, all in the same town and range, may be recorded on this certificate.

A. Description of original monument and accessories and/or subsequent restoration:

1821 GLO; WAMPLER, D.S.; SET POST; BEECH 5 N20W 3LKS., BEECH 8 S2W 5LKS.
1902 FELTON, C.S.; PREV. SET BY WILSON; GAS PIPE; SUGAR 6 S21W 47LKS., W.OAK 14 N14 1/2E 63LKS
1971 ROWE ENG.; SURVEY L.1, PG.192-193 AND WIT CARD; FND. 1/2" BOLT W/NUT; S80°E, 109.68' NAIL W/CAP 40" TREE, S45°E, 49.46' NAIL W/CAP 36" TREE, S15°E, 66.16' NAIL W/CAP P.POLE, EAST, 10.32' NE COR. SEC.4, S65°E, 170.06' NW COR HOUSE, S20°E, 26.53' T-IRON @ C/L ROAD

B. Description of corner evidence found and/or method applied in restoring or reestablishing corner:

1994 ROWE ENG.; FIELD, P.S.#37276; FND. 3/8" PIPE 3' N. OF C/L EXTENDED OF GRAVEL ROAD TO E.
FND. 3/8" PIPE IS 5' LONG, ALSO FND SEVERAL BRICKS AROUND PIPE
ACCEPTED 3/8" PIPE AS BEST EVIDENCE OF ORIGINAL CORNER POSITION

SEE ALSO BACK OF THIS FORM

C. Description of monument for corner and accessories established to perpetuate locating the position of the corner:


G-13 REMOVED PIPE, SET STANDARD MONUMENT (5/8"X 36" ROD W/ BRASS CAP IN CONC.)
S72°E, 110.80' SET NAIL W/REMON TAG IN S. FACE 40" MAPLE
S55°E, 156.18' NW COR. OF CONC. BLOCK FOUNDATION OF ADDITION TO HOUSE #8487
S47°E, 50.12' SET NAIL W/REMON TAG IN NE FACE 36" MAPLE
S20°E, 38.93' SET NAIL W/REMON TAG IN NW FACE 38" MAPLE
S11°E, 63.27' FND. NAIL W/BOTTLE CAP IN N. FACE P.POLE
S23°E, 26.80' FND. T-IRON (BENT) IN C/L GRAVEL ROAD
S88°E, 10.43' FND. 1" ROD
N60°W, 8.81' SET NAIL W/REMON TAG IN SW FACE 14" ASH

COPY

RECEIVED FOR RECORD
LIBER NO. _____ PAGE NO. _____
FILING NO. #50
TUSCOLA TWP
94 NOV 15 AM 10:26
VIRGINIA H. McLEACH
TUSCOLA COUNTY
REGISTER OF DEEDS

Register of Deeds Stamp & File Number

| | | | | | | | | | | | | | |
|----|----|----|----|----|----|----|---|---|---|---|---|---|---|
| 1 | A | B | C | D | E | F | G | H | I | J | K | L | I |
| 2 | 6 | 5 | 4 | 3 | 2 | 1 | | | | | | | |
| 3 | | | | | | | | | | | | | |
| 4 | 7 | 8 | 9 | 10 | 11 | 12 | | | | | | | |
| 5 | | | | | | | | | | | | | |
| 6 | 18 | 17 | 16 | 15 | 14 | 13 | | | | | | | |
| 7 | | | | | | | | | | | | | |
| 8 | 19 | 20 | 21 | 22 | 23 | 24 | | | | | | | |
| 9 | | | | | | | | | | | | | |
| 10 | 30 | 29 | 28 | 27 | 26 | 25 | | | | | | | |
| 11 | | | | | | | | | | | | | |
| 12 | 31 | 32 | 33 | 34 | 35 | 36 | | | | | | | |
| 13 | | | | | | | | | | | | | |

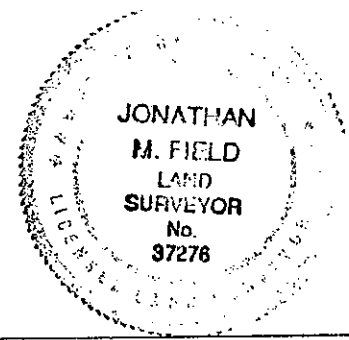

Signed by Jonathan M. Field

Date 11-4-94

Surveyor's Michigan License No. 37276

APPROVED
10-24-94
J.M.F.
J.M.F.

