

**SURVEY &
REMONUMENTATION**

APR 25 1995

COMMISSION

COPY

LAND CORNER RECORDATION CERTIFICATE

Filing Requirement of Act 74, Mich. P.A. 1970
1994 REMONUMENTATION PROGRAM

For corners in TUSCOLA TWP.
TUSCOLA
(County)

Located In:

Corner Code #

- | | | | | | |
|---------------------------------------|---|-----|---|-----|------|
| 1. Public Land Survey | T | 11N | R | 07E | H-13 |
| | T | | R | | |
| | T | | R | | |
| | T | | R | | |
| 2. Property Controlling
in Section | S | T | R | | |
| | S | T | R | | |
| 3. Miscellaneous
Property in Sec. | S | T | R | | |
| | S | T | R | | |
4. Lot No. _____, Recorded Plat _____
5. Private Claims _____

RECEIVED FOR RECORD
LIBER NO. _____ PAGE NO. _____
FILING NO. #61
TUSCOLA TWP
94 NOV 15 AM 10:26
VIRGINIA H. MILLAREN
TUSCOLA COUNTY
REGISTER OF DEEDS

Register of Deeds Stamp & File Number

I, JONATHAN M. FIELD, in a field survey on AUGUST 5 1994, do hereby certify that under requirements of P.A. 74, Michigan P.A. of 1970, the corner points mentioned in lines 1 and 2 above were in conformance with regulations and rules therefore as required in the current manual of survey instructions of the United States Department of the Interior, Bureau of Land Management or by a decree of a Court of Law and/or that the corner points mentioned in lines 3, 4 and 5 above were in conformance with the rules of the Michigan Board of Land Surveyors or by a Decree of a Court of Law; established, re-established, monumented, re-monumented, recovered, found as expressed below:

1	A	B	C	D	E	F	G	H	I	J	K	L
2		6	5	4	3	2	1					
3												
4		7	8	9	10	11	12					
5												
6		18	17	16	15	14	13					
7												
8		19	20	21	22	23	24					
9												
10		30	29	28	27	26	25					
11												
12		31	32	33	34	35	36					
13												

NOTE: Not more than 4 corners, all in the same town and range, may be recorded on this certificate.


A. Description of original monument and accessories and/or subsequent restoration:
1821 GLO; WAMPLER, D.S.; SET POST; SUGAR 14 NORTH 11 LKS., BEECH 22 S71W 28 LKS.
1902 FELTON, C.S.; SET FROM MEAS. OAK POST & CROCK; SUGAR 10 N79W 3.05, SUGAR 10 S81 1/2 2.64
1963 BLACK, P.S.; SURVEY FOR HOWARD NEWTON; OBJECT NOT STATED; WITS NOT GIVEN

B. Description of corner evidence found and/or method applied in restoring or reestablishing corner:
1994 ROWE ENG.; FIELD, P.S.#37276; END. 3/4" PIPE ON C/L GRAVEL RD E-W & ON TREE ROW TO N.
ALSO END BELOW PIPE BRICKS, CROCKERY & CHINA

ACCEPTED 3/4" PIPE AS BEST EVIDENCE OF ORIGINAL CORNER POSITION

SEE ALSO BACK OF THIS FORM

C. Description of monument for corner and accessories established to perpetuate locating the position of the corner:
H-13 REMOVED PIPE, SET STANDARD MONUMENT (5/8"X 36" ROD W/ BRASS CAP IN CONC.)
S66°E, 80.53' SET NAIL W/REMON TAG IN N. FACE OF E. LEG OF POWER TOWER
S60°E, 67.15' SET NAIL W/REMON TAG IN N. FACE OF W. LEG OF POWER TOWER
S07°W, 55.18' SET NAIL W/REMON TAG IN W. FACE P. POLE
N67°E, 29.35' SET 1/2" ROD
N61°W, 23.06' SET 1/2" ROD

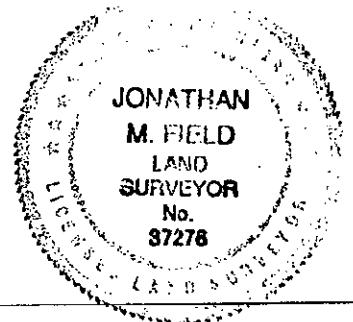

Signed by Jonathan M. Field Date 11-4-94
Surveyor's Michigan License No. 37276

APPROVED
10-28-94

