SURVEY & REMONUMENTATION

APR 2 5 1995

COMMISSION


LAND CORNER RECORDATION CERTIFICATE

Filing Requirement of Act 74, Mich. P.A. 1970

For corners in TUSCO	LA TWP.		REMONUMENTATION PROGRAM	Ī		<u> </u>	芸匠	32	王第	
TUSCOLA	LAX IWP.	Located In:	Corner Code #			STE	235 235		古石石	CEIVED
(County)); ''	> TZ	017		<u>m</u>
1. Public Land Survey		T 11N R 07E T R T R	<u>I-13</u>			T DEEDS		AM 10: 26	_PAGE NO # /oス	FOR RECORD
2. Property Controlling in Section	s	TR TR						6	ĺ	C
3. Miscellaneous	S	TR		Registe	er of D	eeds S	Stamp	& File	Numb	er
Property in Sec.	s	TR								
4. Lot No, i	Recorded	Plat			A B	C D	E F	G H I	JK	LŃ
o. Tittato Olamo				2	6	5	4	3	···2	1
I, JONATHAN M. FIELD , in a field survey on AUGUST 5 19 94 ,					7	8	9	10	11	12
do hereby certify that under requirements of P.A. 74, Michigan P.A. of 1970, the corner points mentioned in lines 1 and 2 above were in conformance with regulations and rules therefore as required in the				5						
current manual of survey instructions of the United States Department of the Interior, Bureau of Land Management or by a decree of a Court of Law and/or that the corner points mentioned in lines 3, 4 and 5				6 7	18	17	16	15	14	13
above were in conformance with the rules of the Michigan Board of Land Surveyors or by a Decree of a Court of Law; established, re-established, monumented, re-monumented, recovered, found as expressed below: NOTE: Not more than 4 corners, all in the same town and range, may be recorded				8 9	19	20	21	22	23	24
				10	30	29	28	27	26	25
on this certific	ate.			11 12	31	32	33	34 ·	35	36
A. Description of origin	nal monur	nent and accessories	s and/or subsequent restoration:	13	L	l	<u> </u>	<u> </u>	<u> </u>	<u> </u>

1821 GLO; WAMPLER, D.S.; SET POST; SUGAR 20 S74 1/2W 17LKS., BEECH 12 EAST 20LKS.

1902 FELTON, C.S.; PREV. SET BY WILSON, ELM POST, STONE & HARD BRICK; NO WITS GIVEN

1993 ROWE ENG.; FIELD, P.S.#37276; MORTGAGE REPORT NOTES; FND. 1/2" PIPE

B. Description of corner evidence found and/or method applied in restoring or reestablishing corner: 1994 ROWE ENG.; FIELD, P.S.#37276; FND 3/4" PIPE 4' S. OF C/L GRAVEL ROAD E-W & 8.3' W. OF C/L ASPH. ROAD N-S. ALSO FND BELOW PIPE POINTED WOOD POST, BRICKS & CHINA

ACCEPTED FND. PIPE AS BEST EVIDENCE OF ORIGINAL CORNER POSITION

SEE ALSO BACK OF THIS FORM

C. Description of monument for corner and accessories established to perpetuate locating the position of the corner: I-13 REMOVED PIPE, SET STANDARD MONUMENT (5/8"X 36" ROD W/ BRASS CAP IN CONC.)

\$46°W, 62.24' FND. P-K NAIL IN NNW FACE CUT-OFF T.POLE

\$53°W, 59.97' CENTER OF ROAD SIGN POST

S26°E, 77.40' FND P-K NAIL IN W. FACE GUY POLE

N55°E, 90.39' FND P-K NAIL IN SSE FACE P.POLE


38.12' SET CHIS. NOTCH IN TOP S. END 18" CSP N66°W.

JONATHAN M. FIELD CMAL SURVEYOR 37276 4 A h U

Surveyor's Michigan License No. 37276

FORM APPROVED BY MICHIGAN STATE BOARD OF LAND SURVEYORS,



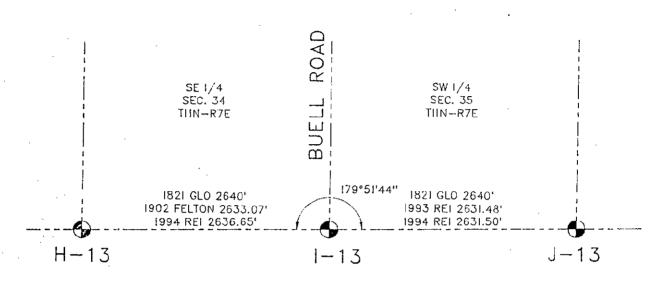

SWAFFER ROAD

COBA