

**SURVEY &
REMONUMENTATION**

APR 25 1995

COMMISSION

COPY

LAND CORNER RECORDATION CERTIFICATE

Filing Requirement of Act 74, Mich. P.A. 1970
1994 REMONUMENTATION PROGRAM

RECEIVED FOR RECORD
LIBER NO. _____ PAGE NO. _____
FILING NO. #63
125204 P TWP
94 NOV 15 AM 10:26
VIRGINIA H. McLANE
TUSCOLA COUNTY
REGISTER OF DEEDS

For corners in TUSCOLA TWP.
TUSCOLA
(County)

Located In:

Corner Code #

1. Public Land Survey	T	11N	R	07E	J-13
	T		R		
	T		R		
	T		R		
2. Property Controlling in Section	S	T	R		
	S	T	R		
3. Miscellaneous Property in Sec.	S	T	R		
	S	T	R		

Register of Deeds Stamp & File Number

4. Lot No. _____, Recorded Plat _____
5. Private Claims _____

I, JONATHAN M. FIELD, in a field survey on AUGUST 5 1994, do hereby certify that under requirements of P.A. 74, Michigan P.A. of 1970, the corner points mentioned in lines 1 and 2 above were in conformance with regulations and rules therefore as required in the current manual of survey instructions of the United States Department of the Interior, Bureau of Land Management or by a decree of a Court of Law and/or that the corner points mentioned in lines 3, 4 and 5 above were in conformance with the rules of the Michigan Board of Land Surveyors or by a Decree of a Court of Law; established, re-established, monumented, re-monumented, recovered, found as expressed below:

NOTE: Not more than 4 corners, all in the same town and range, may be recorded on this certificate.

A. Description of original monument and accessories and/or subsequent restoration:

1821 GLO; WAMPLER, D.S.; SET POST; LYNN 7 N42E 10LKS., LYNN 9 S10W 5LKS.
1987 DUNTON SURVEYING; DUNTON, P.S.#23503; FND NOTHING - SET 1/2" ROD W/CAP #23503 BY SINGLE PROPORTION; N. 26.2' P-K NAIL E. FACE 28" WALNUT, S45°E 43.7' P-K NAIL ROOT 18" MAPLE, S55°W 53.70' P-K NAIL IN NW FACE 30" MAPLE, W. 21.2' C/L

B. Description of corner evidence found and/or method applied in restoring or reestablishing corner:


1994 ROWE ENG.; FIELD, P.S.#37276; FND. 1/2" ROD W/CAP #23503 ON C/L GRAVEL ROAD E-W & ON TREE ROW & FIELD DIVISION LINE TO N.

ACCEPTED FND. 1/2" ROD AS BEST EVIDENCE OF ORIGINAL CORNER POSITION

SEE ALSO BACK OF THIS FORM

C. Description of monument for corner and accessories established to perpetuate locating the position of the corner:

J-13 REMOVED ROD, SET STANDARD MONUMENT (5/8" X 36" ROD W/ BRASS CAP IN CONC.)
EAST, 23.62' FND. 3/4" PIPE
N70°E, 31.88' SET 1/2" ROD
NORTH, 25.99' SET NAIL W/REMON TAG IN E. FACE 34" WALNUT
S54°W, 53.70' FND P-K NAIL IN NW FACE 30" MAPLE
S45°E, 43.77' FND P-K NAIL IN E. ROOT OF 30" MAPLE

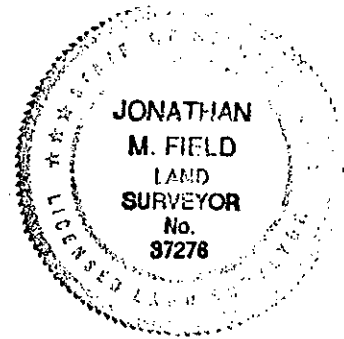

Signed by Jonathan M Field Date 11-4-94
Surveyor's Michigan License No. 37276

APPROVED
10-24-94
JMF



BUELL ROAD

SW 1/4
SEC. 35
T11N-R7E

SE 1/4
SEC. 35
T11N-R7E

1821 GLO 2640'
1993 REI 2631.48'
1994 REI 2631.50'

179°59'48"

1821 GLO 2640'
1994 REI 2631.62'

I-13

J-13

K-13

SWAFFER ROAD

COBY