## 1999 REMONUMENTATION PROGRAM LAND CORNER RECORDATION CERTIFICATE

Filing Requirement of Act 74, Mich. P.A. 1970

RECEIVED FOR RECORD LIĐER NO. \_\_PAGE NO.\_ TUSCOLA 99 DEC -7 AM 9: 16

any more

For corners in: TUSCOLA TWP.							)	
TUSCOLA (County)	Located In:	Corner Code #	TUSCOLA COUNTY REGISTER OF DEEDS					
Public Land Survey	T <u>11N</u> R <u>07E</u> TR TR	<u>K-10</u>		James Joseph Jos				
<ol> <li>Property Controlling in Section</li> <li>Miscellaneous</li> </ol>	S T R S T R S T R	F	tegister o	Deeds S	Stamp 8	& File N	lumber	-
Property in Sec.	S T R	<u>.</u>	, A E	C D	E F	G Н	l J k	
4. Lot No, Recorded Plat 5. Private Claims			2 6	5	4	3	2	1
		•	4 7	8	9	10	11	12
I, Mark W. Powell, P.S. , in a field survey on May 26 19 99 , do hereby certify that under requirements of P.A. 74, Michigan P.A. of 1970, the corner points mentioned in lines 1 and 2 above were in conformance with regulations and rules therefore as required in the			, ed 6 18	3 17	16	15	14	13
current manual of survey instructions of the United States Department of the Interior, Bureau of Land Management or by a decree of a Court of Law and/or that the corner points mentioned in lines 3, 4 and 5 above were in conformance with the rules of the Michigan Board of Land Surveyors or by a Decree of a			1d 8 19	20	21	22	23	24
		re-monumented, recovered, found		29	28	27	26	25
NOTE: Not more than 4 corners, all in the same town and range, may be recorded on this certificate.			12 31	32	33	34	35	36
			,,					

- Description of original monument and accessories and/or subsequent restoration:
- 1822 GLO; FLETCHER, D.S.; SET POST; LYNN 10 S23W 17LKS, ELM 20 N40E 9LKS

1978 BECK-GRAVLIN; BECK, P.S. #21559, SURVEY L. 488, P.G. 548; SHOWS CORNER ON SURVEY, NO DESCRIPTION OF MONUMENT LISTED, NO ACCESSORIES LISTED

1980 ROWE ENG.; FOKENS, P.S. #21567, SURVEY L. 509, PG. 094; "T" IRON, N55E, 34.7' ROAD SIGN, N45E 42.05' N. END 30" CMP, S75E 31.57' S. END 30" CMP

1984 ROWE ENG.; WINIARSKI, P.S. #23857, SURVEY L. 545, PG. 1082; "T" IRON, N55E 34.7' ROAD SIGN, N45E 42.05' N. END 30" CMP, S75E 31.57' S. END 30" CMP

Description of corner evidence found and/or method applied in restoring or reestablishing corner:

44298

1999 FOUND "T"-IRON

I ACCEPT THE "T"-IRON AS THE OBJECT OF RECORD AND AS A CAREFUL AND FAITHFUL PERPETUATION OF THE POSITION OF THE ORIGINAL CORNER

Description of monument for corner and accessories established to perpetuate locating the position of the corner:

I REMOVED THE "T"-IRON AND SET THE STANDARD MONUMENT (5/8" X 36" ROD WITH BRASS CAP IN CONCRETE) STAMPED K-10, T11N-R7E, P.S. #44298 AND INSTALLED MONUMENT BOX OVER MONUMENT

S60E 42.67' SET P.K. NAIL & TAG #37276 IN S. END 30" CMP

N80W 14.00' S'LY EDGE OF S'LY LEG OF SIGN POST

N70W N'LY EDGE OF N'LY LEG OF SIGN POST 15.00'

N45W SET 1/2 " RE-ROD & CAP #37276 14 33'

SET P.K. NAIL & TAG #37276 IN N. END 30" CMP N50E 42.04

S45W 21.00' SET 1/2 " RE-ROD & CAP #37276

N60E 40.831 S'LY EDGE OF "YIELD" SIGN POST

OF MICH MARK W POWELL **PROFESSIONAL** SURVEYOR No. POFESS

12-2-1999

Surveyor's Michigan License No.




## SECTION 25

ERROR OF CLOSURE

AFTER BALANCING ANGLES = 1 IN 3,116,090

ADJUSTED COMPASS RULE METHOD

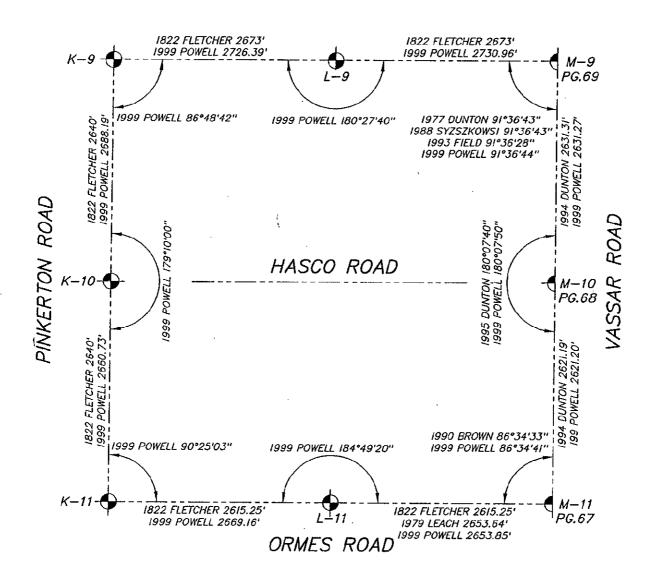

