RECEIVED FOR RECORD

	LIBER NOPAGE NO
	FILE NO #82
RAM	TUSOLA TWP

12 31 32

1999 REMONUMENTATION PROGRAM

TUSTOLA TWP.

LAND CORNER RECORDATION CERTIFICATE 99 DEC -7 AM 9: 16

Filing Requirement of Act 74, Mich. P.A. 1970

TUSCOLA TWP. For corners in: Corner Code # Located In: TUSCOLA K-11 T 11N R 07E 1. Public Land Survey 2. Property Controlling R Register of Deeds Stamp & File Number R in Section S 3. Miscellaneous Property in Sec. D F G Н 1 _, Recorded Plat 2 Ì 4. Lot No. 2 3 6 5 5. Private Claims 3 12 11 7 8 9 10 19 99 🕟 May 26 in a field survey on ı, Mark W. Powell, P.S. do hereby certify that under requirements of P.A. 74, Michigan P.A. of 1970, the corner points mentioned 14 13 15 16 18 17 in lines 1 and 2 above were in conformance with regulations and rules therefore as required in the current manual of survey instructions of the United States Department of the Interior, Bureau of Land 7 23 24 20 21 22 8 19 Management or by a decree of a Court of Law and/or that the corner points mentioned in lines 3, 4 and 5 above were in conformance with the rules of the Michigan Board of Land Surveyors or by a Decree of a 9 Court of Law, established, re-established, monumented, re-monumented, recovered, found as 27 26 25 28 10 30 29 11 36 33 34 35

Description of original monument and accessories and/or subsequent restoration:

NOTE: Not more than 4 corners, all in the same town and range, may be recorded

1822 GLO; FLETCHER, D.S.; SET POST; SUGAR 14 S30W 18LKS, BIRCH 10 N48E 12LKS

1976 LEACH, P.S. #7236; LCRC PG. 24; FOUND PK. NAIL FLUSH WITH BLACKTOP; N35E 53.16' TO 2" SIGN POST (ORMES & PINKERTON), N30W 42.97' TO TP RISER, S5W 56.60' TO P.P.

1978 BECK-GRAVLIN; BECK, P.S. #21559; SURVEY L. 488 PG. 548; NO DESCRIPTION OF MONUMENT LISTED; N35E 55.0' ROAD SIGN, N40W 34.35' STOP SIGN, S10W 54.28' NAIL & WASHER IN POWER POLE.

1987 DUNTON, P.S. #23503; SURVEY L. 595 PG. 059-060; FND. T IRON; S05W 54.3' PK IN P.P., N45W 53.7' N. END C.S.P., N45E 51.3' E. END C.S.P., NORTH 2.2' C/L E-W PAVE.

Description of corner evidence found and/or method applied in restoring or reestablishing corner:

1999 FOUND "T"-IRON IN A MONUMENT BOX

on this certificate.

I ACCEPT THE "T"-IRON IN A MONUMENT BOX AS THE OBJECT OF RECORD AND AS A CAREFUL AND FAITHFUL PERPETUATION OF THE POSITION OF THE ORIGINAL CORNER.

Description of monument for corner and accessories established to perpetuate locating the position of the corner:

I REMOVED THE "T"-IRON AND SET THE STANDARD BRASS CAP STAMPED K-11, T11N-R7E, P.S. #44298 ON A 5/8" RE-ROD IN A MONUMENT BOX, ENCASED 5/8" RE-ROD AND CAP IN CONCRETE IN MONUMENT BOX

SET P.K. NAIL & TAG #37276 W, FACE P.POLE S08W 55.65' SET CHISELED "X" ON RIVET E. END 54" CMP 50.93' N55E SET CHISELED "X" ON RIVET N. END 54" CMP N50W 53.75' E'LY EDGE "STOP" SIGN POST N20W 34.28' TOP CENTER OF TELEPHONE RISER N25W 45.681 SET 1/2 " RE-ROD & CAP #37276 S65E 28.10'





Signed by Mark W	Powell	Date	12-2-1999	
Surveyor's Michigan License No.	44298 APPRO 12-Z-/3	VED EMC FORNAF		EVISED JAN., 1913



ORMES ROAD

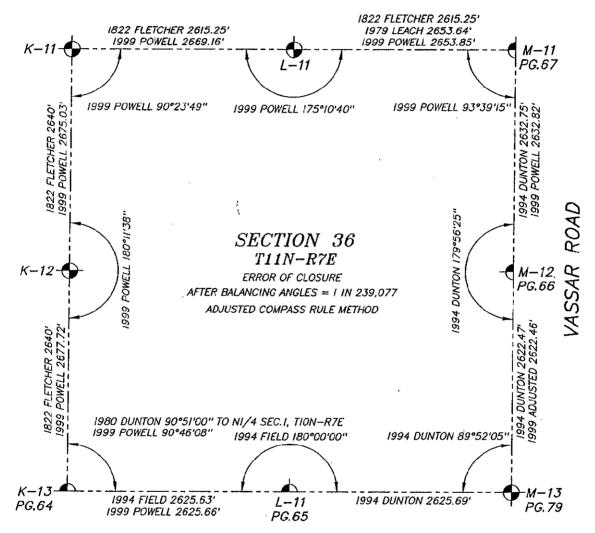

SWAFFER ROAD


L