1999 REMONUMENTATION PROGRAM

LAND CORNER RECORDATION CERTIFICATE

Filing Requirement of Act 74, Mich. P.A. 1970

RECEIVED FOR RECORD LIBER NO. PAGE NO. FILE 110_#86. 24 AM 9: 17

Register of Deeds Stamp & File Number

For corners in: TUSCOLA TWP.

Property in Sec.

TUSCOLA Located In: Corner Code # (County) Public Land Survey T_11N R 07E 2. Property Controlling R S in Section S R 3. Miscellaneous S R

4. Lot No Recorded Plat 5. Private Claims

J. Mark W. Powell, P.S. in a field survey on October 26 do hereby certify that under requirements of P.A. 74, Michigan P.A. of 1970, the corner points mentioned in lines 1 and 2 above were in conformance with regulations and rules therefore as required in the current manual of survey instructions of the United States Department of the Interior, Bureau of Land Management or by a decree of a Court of Law and/or that the corner points mentioned in lines 3, 4 and 5 above were in conformance with the rules of the Michigan Board of Land Surveyors or by a Decree of a Court of Law; established, re-established, monumented, re-monumented, recovered, found as expressed below:

NOTE: Not more than 4 corners, all in the same town and range, may be recorded on this certificate.

ABCDEFGHIJKLA						
2	6	5	4	3	2	1
4 5	7	8	9	10	11	12
6	18	17	16	15	14	13
7 8 9	19	20	21	22	23	24
10	30	29	28	27	26	25
11 12 13	31	32	33	34	35	36

- Description of original monument and accessories and/or subsequent restoration:
- 1822 GLO; FLETCHER, D.S.; SET POST; BEECH 24 S27W 14LKS, BEECH 12 S13E 29LKS
- 1977 DUNTON, P.S. 23503; LCRC PG. 39; FND 1/2" X 1 1/4" CAST STEEL BAR & ABUNDANT CROCKERY, SET 1/2" ROD: N45E 21.30' RLS 11192 TAG IN 8" OAK, N55E 11.10' RLS 11192 TAG IN 6" MAPLE, S10E 31.82' RLS 11192 TAG IN 7" CHERRY, S40E 10.60' RLS 11192 TAG IN 12" OAK
- 1977 ROWE ENG.; DUNTON, P.S. #23503; SURVEY L. 485, PG. 415-416; 1/2" RE-ROD; N45E 21.30' RLS 11192 TAG IN 8" OAK, N55E 11.10' RLS 11192 TAG IN 6" MAPLE, S10E 31.82' RLS 11192 TAG IN 7" CHERRY, S40E 10.60' RLS 11192 TAG IN 12" OAK
- 1988 DUNTON, P.S. #23503; SURVEY L. 582 PG. 960; FND. 1/2 "IRON; N45E 21.30' RLS 11192 TAG IN 8" OAK, N55E 11.10" RLS 11192 TAG IN 6" MAPLE, S10E 31.82' RLS 11192 TAG IN 7" CHERRY
- 1988 SZYSZKOSKI, P.S. #33986; LCRC PG 52; FOUND 1/2" RE-ROD W/ CAP #11192; \$25E 6.87' SET NAIL & TAG #11192 W. FACE 9" MAPLE, N45E 21.30' FND. TAG #11192 IN 8" OAK, N55E 11.10' FND. TAG #11192 6" MAPLE, S15W 35.57' SET NAIL & TAG #11192 E. FACE 7" ASH, SOUTH 32.5' +/- E-W WIRE FENCE

A. CONTINUED ON BACK:

Description of corner evidence found and/or method applied in restoring or reestablishing corner:

1999 FOUND 1/2 " RE-ROD & CAP #11192

| ACCEPT THE 1/2 " RE-ROD & CAP #11192 AS THE OBJECT OF RECORD AND AS A CAREFUL AND FAITHFUL PERPETUATION OF THE POSITION OF THE ORIGINAL CORNER.

Description of monument for corner and accessories established to perpetuate locating the position of the corner:

I REMOVED THE 1/2 " RE-ROD & CAP #11192 AND SET THE STANDARD MONUMENT (5/8" X 36" ROD WITH BRASS CAP IN CONCRETE) STAMPED L-9, T11N-R7E, P.S. #44298 AND SET CARSONITE POST ALONGSIDE MONUMENT

NORTH 24.47' SET NAIL & ROWE TAG N. FACE 6" OAK **EAST** 35.63' SET NAIL & ROWE TAG E. FACE 10" ASPEN S25E FOUND NAIL & TAG #11192 W. FACE 16" MAPLE FOUND NAIL & TAG #11192 E. FACE 12" ASH S15W 35.55

in the Mindle or security

Mark

No.

OF MICH

MARK W

POWELL PROFESSION

SURVEYOF


Surveyor's Michigan License No.

APPROVED

TO THE MANAGEMENT


A. CONTINUED:

1988 ROWE ENG.;SZYSZKOSKI, P.S. #33986; SURVEY L. 589, PG. 336-337; FOUND ½" RE-ROD W/ CAP #11192; S25E 6.87' SET NAIL & TAG #11192 W. FACE 9" MAPLE, N45E 21.30' FND. TAG #11192 IN 8" OAK, N55E 11.10' FND. TAG #11192 6" MAPLE, S15W 35.57' SET NAIL & TAG #11192 E. FACE 7" ASH, SOUTH 32.5' +/- E-W WIRE FENCE 1993 ROWE ENG.; FIELD, P.S. #37276; SURVEY L. 644 PG. 311-312; FOUND ½" RE-ROD; S25E 6.87' FND.NAIL W/ TAG #11192 W. FACE 12" MAPLE, N45E 21.30' FND. NAIL W/ TAG #11192 IN 10" OAK, N55E 11.10' FND. NAIL W/ TAG #11192 IN 10" MAPLE, S15W 35.57' FND. NAIL W/ TAG #11192 E. FACE 10" ASH



SECTION 25 T11N-R7E

ERROR OF CLOSURE
AFTER BALANCING ANGLES = 1 IN 3,116,090
ADJUSTED COMPASS RULE METHOD

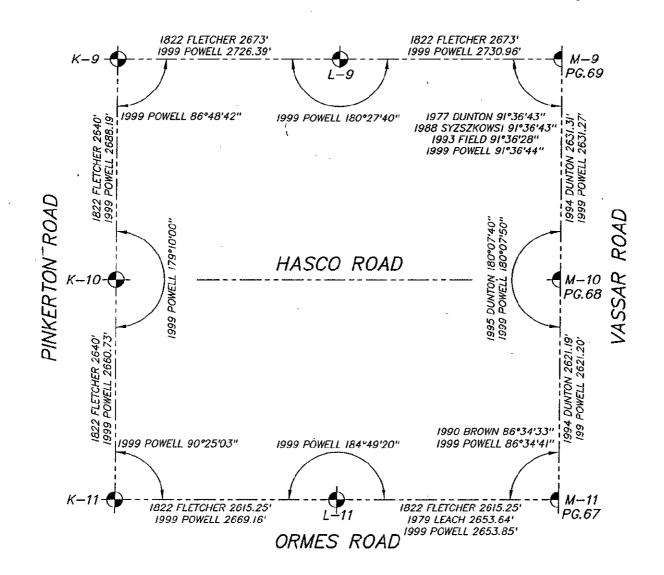

