1999 REMONUMENTATION PROGRAM LAND CORNER RECORDATION CERTIFICATE Filing Requirement of Act 74, Mich. P.A. 1970

RECEIVED FOR RECORD LIBER NO.____PAGE NO._ FILE NO. #83 TUSCOLA TWP, 99 DEC-7 AM 9: 16

annestroles

For corners in: TUSCOLA TWP.						ı	TUSCOLA COUNTY REGISTER OF DEEDS							
TUSCOLA		Located In:		Co	Corner Code #			REGISTER OF DEED'S						
(County)						ŀ								
1. Public Land Survey	T 11N R 07E T R T R T R							,		** . IF .	S. S			
2. Property Controlling	s	_ T	R R			.								
in Section 3. Miscellaneous Property in Sec.	s s	T	_ R _ R _ R			Re	gist	er of D	eeds S	tamp 8	File N	umber	-	
4. Lot No,	Recorde	d Plat						А В	Ţ	E F (T	IJK	C L N	
4. Lot No, 5. Private Claims,						<u> </u>	2 3	6	5	4	3	2	1	
						•	4	7	8	Ş	10	11	12	
I. <u>Mark W. Powell, P.S.</u> , in a field survey on <u>May 26</u> 19 99, do hereby certify that under requirements of P.A. 74, Michigan P.A. of 1970, the corner points mentioned in lines 1 and 2 above were in conformance with regulations and rules therefore as required in the							5 6	18	17	16	15	14	13	
current manual of survey instructions of the United States Department of the Interior, Bureau of Land Management or by a decree of a Court of Law and/or that the corner points mentioned in lines 3, 4 and above were in conformance with the rules of the Michigan Board of Land Surveyors or by a Decree of a						, 8 5	19	20	21	22	23	24		
Court of Law; established, re-established, monumented, re-monumented, recovered, for expressed below:							30	29	28	27	26	25		
NOTE: Not more than 4 corners, all in the same town and range, may be recorded on this certificate.							12	31	32	33	34	35	36	
A. Description of origin	al monun	nent and	accessories a	and/or sub	sequent restora	ation:								

1822 GLO; FLETCHER, D.S.; SET POST; BIRCH 12 N47E 4LKS, BIRCH 16 S23W 12LKS

1976 LEACH, P.S. #7236; LCRC PG. 24; SET P.K. NAIL USING ROAD COMM, WITNESSES: N30W 40,32' SPIKE IN ROOT 36" MAPLE, N55W 157.62' S.E. COR. HOUSE #6284, NORTH 1.0' TO EDGE OF BLACKTOP

1979 LEACH, P.S. #7236; SURVEY L. 499 PG. 991-992; SET LARGE P.K. NAIL; SOUTH 47,00' TOP CTR. TELE. RISER, N30W 40.32' SPIKE IN ROOT 36" MAPLE, N55W 157.62' S.E. COR. HOUSE

1990 ROWE ENG.; BROWN, P.S. #33134; SURVEY L. 604 PG. 1378-1379; FND. 5/8" ROD; NORTH 1.2' N. EDGE ORMES RD. (ASPH), SOUTH 9.2' PHYS. C/L ORMES RD. (ASPH), N35W 40.3' +/- CENTER 36" MAPLE STUMP, S10W 46.35' TOP CENTER OF PHONE RISER, N10E 41.23' FND NAIL & TAG #11192 S.E. FACE T. POLE, N45W 51.74' FND. NAIL & TAG #11192 S.W. FACE 36" MAPLE, S05W 80.25' SET P.K. & TAG #11192 E. FACE P. POLE, WEST 100.03' FND. P.K. IN ASPH RD. LABLED T-4

Description of corner evidence found and/or method applied in restoring or reestablishing corner:

1999 FOUND 3/4" RE-ROD IN A MONUMENT BOX

I ACCEPT THE 3/4" RE-ROD IN A MONUMENT BOX AS THE OBJECT OF RECORD AND AS A CAREFUL AND FAITHFUL PERPETUATION OF THE POSITION OF THE ORIGINAL CORNER.

Description of monument for corner and accessories established to perpetuate locating the position of the corner:

I REMOVED THE 3/4" RE-ROD AND SET THE STANDARD BRASS CAP STAMPED L-11, T11N-R7E, P.S. #44298, ON A 5/8" RE-ROD IN A MONUMENT BOX, ENCASED 5/8" RE-ROD AND CAP IN CONCRETE IN MONUMENT BOX

NORTH 1.5' EDGE OF BIT.

N60W 157 731 SE CORNER HOUSE

N45W 51.72' FOUND NAIL & TAG #11192 SW FACE 42" MAPLE

FOUND NAIL & TAG #11192 ESE FACE P. POLE N10E 41.24

S10W 80.30' FOUND P.K. NAIL & TAG #11192 E, FACE P. POLE

44298

S10W 46.861 TOP CENTER OF TELEPHONE RISER

SOUTH 8.5' PHYSICAL CENTERLINE OF ORMES ROAD

Signed by_

Date

Surveyor's Michigan License No.

APPROVED 12-2-1999

DARD OF LAND SURVEYORS, JAN. 28, 197 REVISED MAY 14, 1975 REVISED JAN., 1983 PROCESSING MARCH, 1995

OF MICH

MARK W.

POWELL

PROFESSIONAL


SURVEYOR

No 44298 OF FCS

1



ORMES ROAD

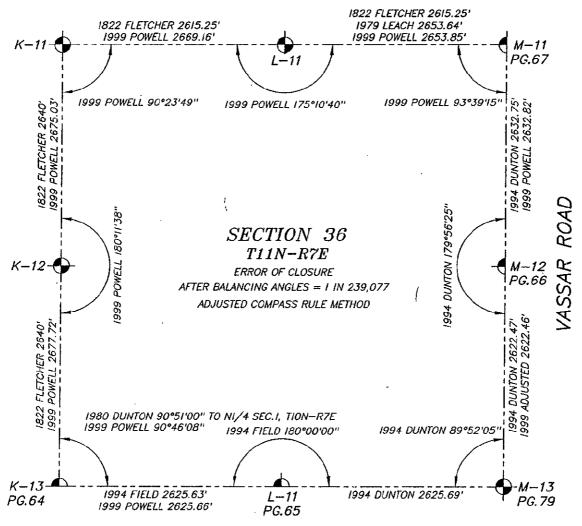

SWAFFER ROAD

