

**1995 REMONUMENTATION PROGRAM  
LAND CORNER RECORDATION CERTIFICATE  
Filing Requirement of Act 74, Mich. P.A. 1970**

For corners in Tuscola Township

<u>Tuscola</u> <small>(County)</small>	Located In:	Corner Code #
1. Public Land Survey	T <u>11N</u> R <u>7E</u>	<u>M-1</u>
	T _____ R _____	<u>amended</u>
	T _____ R _____	_____
	T _____ R _____	_____
2. Property Controlling in Section	S _____ T _____ R _____	_____
	S _____ T _____ R _____	_____
3. Miscellaneous Property in Sec.	S _____ T _____ R _____	_____
	S _____ T _____ R _____	_____

RECEIVED FOR RECORD  
LIBER NO. \_\_\_\_\_ PAGE NO. \_\_\_\_\_  
FILING NO. # 70  
TUSCOLA TWP,  
95 OCT -5 PM 2:08  
VIRGINIA M. McCLAREN  
TUSCOLA COUNTY  
REGISTER OF DEEDS

Register of Deeds Stamp & File Number

4. Lot No. \_\_\_\_\_, Recorded Plat \_\_\_\_\_  
5. Private Claims \_\_\_\_\_

A	B	C	D	E	F	G	H	I	J	K	L	M
2	6	5	4	3	2	1						
3												
4	7	8	9	10	11	12						
5												
6	18	17	16	15	14	13						
7												
8	19	20	21	22	23	24						
9												
10	30	29	28	27	26	25						
11												
12	31	32	33	34	35	30						
13												

I, Kenneth D. Dunton, in a field survey on August 12, 19 95, do hereby certify that under requirements of P.A. 74, Michigan P.A. of 1970, the corner points mentioned in lines 1 and 2 above were in conformance with regulations and rules therefore as required in the current manual of survey instructions of the United States Department of the Interior, Bureau of Land Management or by a decree of a Court of Law and/or that the corner points mentioned in lines 3, 4 and 5 above were in conformance with the rules of the Michigan Board of Land Surveyors or by a Decree of a Court of Law; established, re-established, monumented, re-monumented, recovered, found as expressed below:

**NOTE: Not more than 4 corners, all in the same town and range, may be recorded on this certificate.**

A. Description of original monument and accessories and/or subsequent restoration:

1821 G.L.O. Notes Joseph Wampler, D.S. Intersected township line 15.00 West. Beech 10 S75W 9 Sugar 9 N26E 47	Nov., 1973 Act 74 form filed by John W. Martin, L.S. #4699 on Page 22, Vassar Township. 1 1/2" iron pipe. N.W. 100.00' to S.E. cor. stone found., hse. S.W. 59.10' to fee. t. pole.
---	---

Section A continued on back of this form.

B. Description of corner evidence found and/or method applied in restoring or reestablishing corner:

Found and accepted 5/8" re-rod in monument box as the proper location of corner M-1 amended.


C. Description of monument for corner and accessories established to perpetuate locating the position of the corner:

Placed standard brass cap stamped corner M-1 amended, T11N-R7E over 5/8" re-rod found in mon. box. Encased cap & rod in concrete in mon. box.  
S27°10'W 59.20' fnd. #11192 tag & nail in N.W. face t. pole, set T.C. Remon. tag & spike above.  
N44°07'W 99.70' SE corner footings house #6108. (stones covered)  
N14°46'W 77.85' set T. C. Remon. tag & spike in East root 30" tree.  
S36°56'E 105.25' fnd. p. k. nail in W. face p. pole, set T. C. Remon. tag & spike of above.  
East 1115.43' fnd. iron stake in mon. box at, apparent cor. M-13, T12N-R7E

Signed by [Signature] Date 10-2-95

Surveyor's Michigan License No. 23503

**APPROVED**  
10-2-95

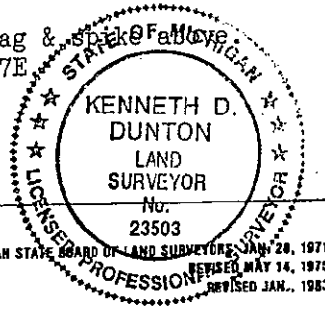

FORM APPROVED BY MICHIGAN STATE BOARD OF LAND SURVEYORS, JAN 20, 1971  
REVISED MAY 14, 1975  
REVISED JAN., 1983

DEC 01 1995  
COMMISSION

**COPY**

Section A continued:

April 3, 1985 Survey by Earl E. Gravlin, L.S. #23510, recorded in Liber 553 on Page 062, Tuscola County Records. Fnd. 1/2" iron and cap. S30°W 59.15' t.p., N20°W 77.85' 30" maple, N15°E 21.20' E. end 12" C.M.P.

