

**1995 REMONUMENTATION PROGRAM
LAND CORNER RECORDATION CERTIFICATE
Filing Requirement of Act 74, Mich. P.A. 1970**

For corners in Tuscola Township

<u>Tuscola</u> (County)	Located In:	Corner Code #
1. Public Land Survey	T <u>11N</u> R <u>7E</u>	<u>M-2</u>
	T _____ R _____	_____
	T _____ R _____	_____
	T _____ R _____	_____
2. Property Controlling in Section	S _____ T _____ R _____	_____
	S _____ T _____ R _____	_____
3. Miscellaneous Property in Sec.	S _____ T _____ R _____	_____
	S _____ T _____ R _____	_____
4. Lot No. _____, Recorded Plat _____		
5. Private Claims _____		

RECEIVED FOR RECORD
LIBER NO. _____ PAGE NO. _____
FILING NO. # 71
TUSCOLA TWP.
95 OCT -5 PM 2:08
VIRGINIA H. McCLAREN
TUSCOLA COUNTY
REGISTER OF DEEDS

Register of Deeds Stamp & File Number

A	B	C	D	E	F	G	H	I	J	K	L	M
2	6	5	4	3	2	1						
3												
4	7	8	9	10	11	12						
5												
6	18	17	16	15	14	13						
7												
8	19	20	21	22	23	24						
9												
10	30	29	28	27	26	25						
11												
12	31	32	33	34	35	36						
13												

I, Kenneth D. Dunton in a field survey on August 12, 19 95, do hereby certify that under requirements of P.A. 74, Michigan P.A. of 1970, the corner points mentioned in lines 1 and 2 above were in conformance with regulations and rules therefore as required in the current manual of survey instructions of the United States Department of the Interior, Bureau of Land Management or by a decree of a Court of Law and/or that the corner points mentioned in lines 3, 4 and 5 above were in conformance with the rules of the Michigan Board of Land Surveyors or by a Decree of a Court of Law; established, re-established, monumented, re-monumented, recovered, found as expressed below:

NOTE: Not more than 4 corners, all in the same town and range, may be recorded on this certificate.

A. Description of original monument and accessories and/or subsequent restoration:

1821 G.L.O. Notes Joseph Wampler, D.S. Set 1/4 sec. post Beech 9 S17W 14 Sugar 18 North 12	Nov., 1973 Act 74 form filed by John W. Martin, L.S. #4699 on Page 22, Vassar Township. 5/8" iron pipe. N.W. 83.18' to fce. 14" cedar N.E. 55.66' to fce. p. pole S.W. 55.66' to Center St. sign post
--	--

Section A continued on back of this form.

B. Description of corner evidence found and/or method applied in restoring or reestablishing corner:

Found and accepted 5/8" re-rod in monument box as the proper location of Corner M-2.

C. Description of monument for corner and accessories established to perpetuate locating the position of the corner:


Placed standard brass cap stamped Corner M-2, T11N-R7E over 5/8" re-rod in mon. box. Encased cap & rod in concrete in mon. box.
S41°46'W 43.95' fnd. notch atop S. end of 50' of 15" C.S.P.
N57°36'W 32.01' fnd. notch atop N. end of 50' of 15" C.S.P.
N36°35'W 83.37' set spike & remon. tag in NE root of 18" cedar.
N83°56'E 56.18' fnd. p. k. nail in S. face p. pole. (p. k. below road gr.)
Set spike & remon. tag in S. face p. pole above p. k.

Signed by [Signature]

Date 10-2-95

Surveyor's Michigan License No. 23503

APPROVED
10-2-95

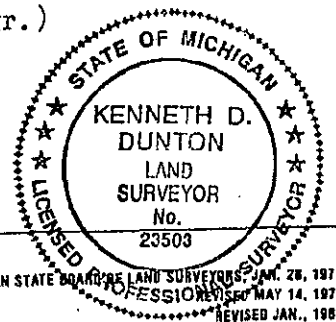

FORM APPROVED BY MICHIGAN STATE BOARD OF LAND SURVEYORS, JAN. 28, 1971
REVISION MAY 14, 1975
REVISED JAN., 1983

DEC 6, 1995
COMMISSION

COPY

Section A continued:

April 3, 1985 Survey by Earl E. Gravlin, L.S. #23510, recorded in Liber 553 on Page 062, Tuscola County Records. Fnd. 1/2" pipe. N80°E 55.86 p. p., N45°W 83.50' 20" cedar, S60°W 48.11' steel rd. sign post.

