

**1995 REMONUMENTATION PROGRAM  
LAND CORNER RECORDATION CERTIFICATE  
Filing Requirement of Act 74, Mich. P.A. 1970**

For corners in Tuscola Township

<u>Tuscola</u> (County)	Located In:	Corner Code #
1. Public Land Survey	T <u>11N</u> R <u>7E</u>	<u>M-5</u>
	T _____ R _____	_____
	T _____ R _____	_____
	T _____ R _____	_____
2. Property Controlling in Section	S _____ T _____ R _____	_____
	S _____ T _____ R _____	_____
3. Miscellaneous Property in Sec.	S _____ T _____ R _____	_____
	S _____ T _____ R _____	_____
4. Lot No. _____, Recorded Plat _____		
5. Private Claims _____		

RECEIVED FOR RECORD  
LIBER NO. \_\_\_\_\_ PAGE NO. \_\_\_\_\_  
FILING NO. # 74  
TUSCOLA TWP.  
95 OCT -5 PM 2:09  
VIRGINIA H. McLAREN  
TUSCOLA COUNTY  
REGISTER OF DEEDS

Register of Deeds Stamp & File Number

A	B	C	D	E	F	G	H	I	J	K	L	M
2	6	5	4	3	2	1						
3												
4	7	8	9	10	11	12						
5												
6	18	17	16	15	14	13						
7												
8	19	20	21	22	23	24						
9												
10	30	29	28	27	26	25						
11												
12	31	32	33	34	35	36						
13												

I, Kenneth D. Dunton in a field survey on June 18, 1995, do hereby certify that under requirements of P.A. 74, Michigan P.A. of 1970, the corner points mentioned in lines 1 and 2 above were in conformance with regulations and rules therefore as required in the current manual of survey instructions of the United States Department of the Interior, Bureau of Land Management or by a decree of a Court of Law and/or that the corner points mentioned in lines 3, 4 and 5 above were in conformance with the rules of the Michigan Board of Land Surveyors or by a Decree of a Court of Law; established, re-established, monumented, re-monumented, recovered, found as expressed below:

**NOTE: Not more than 4 corners, all in the same town and range, may be recorded on this certificate.**

A. Description of original monument and accessories and/or subsequent restoration:

1821 G. L. O. Notes  
Joseph Wampler, D.S.  
Set post corner to Sections 12 & 13  
Beech 30" S 18 1/2 W 6  
Beech 12" N 8 W 20

June 2, 1964 R. J. Black, R.L.S. #3384 witness card. North 298.40' to SW cor. Sec. 7, Vassar Twp., S50°W 77.15' to NE cor. of house, S45°E 42.65' to power pole, S85°W 25.50' to 20" maple.

Section A continued on back of this form.


B. Description of corner evidence found and/or method applied in restoring or reestablishing corner:

Found and accepted 3/4" iron pipe in monument box as the proper location of corner M-5, T11N-R7E.

SURVEY &  
REMONUMENTATION  
DEC 2 1995  
COMMISSION

C. Description of monument for corner and accessories established to perpetuate locating the position of the corner:

Placed standard brass cap stamped corner M-5, T11N-R7E over 3/4" pipe found in mon. box. Encased cap and pipe in concrete in mon. box.  
S45°53'W 85.04' fnd. p. k. nail & tag #37276 in N. face t. pole.  
N26°40'W 49.84' fnd. spike & tag #37276 in E. face 32" maple.  
N17°48'W 116.42' fnd. spike & tag #37276 in S. face twin 22" poplar.  
N38°28'E 85.28' SW corner conc. base of treatment plant sign.  
S58°56'E 42.76' fnd. p. k. nail & tag #37276 in N. face p. pole.  
N00°24'10"W 298.49' fnd. p. k. nail shaft at apparent corner A-5, T11N-R8E.

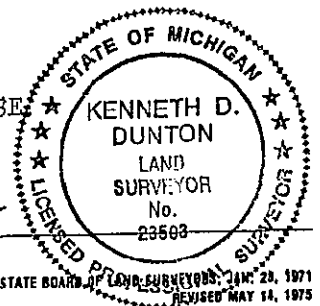

Signed by [Signature] Date 10-2-95  
Surveyor's Michigan License No. 23503

APPROVED  
10-2-95

FORM APPROVED BY MICHIGAN STATE BOARD OF LAND SURVEYORS, JAN. 29, 1971  
REVISED MAY 14, 1975  
REVISED JAN., 1983

COPY

Section A continued:

Sept. 15, 1977 Act 74 form filed by John W. Martin, R.L.S. #4699, on Page 32, Tuscola Co. records. Found 3/4" pipe. S60°W 77.15' to NE cor. blk. foundation house, N85°W 43.45' to fce. 18" walnut, N20°W 49.60' to fce. 30" maple, S60°E 42.65' to fce. p. pole.

Nov. 12, 1993 Survey by Jonathan M. Field, L.S. #37276 with Rowe Eng., Inc., recorded in Liber 655 on Pages 459 & 460, Tuscola Co. Records. Fnd. 3/4" pipe in mon. box. N20°W 116.44' fnd. nail w/tag #37276 in S. face 20" poplar, N30°W 49.84' fnd. nail w/tag #37276 in E. face 38" maple, S40°W 84.94' fnd. p.k. nail w/tag #37276 in N. face t. pole, S65°E 42.74' fnd. p.k. nail w/tag #37276 in N. face p. pole.

