

**1995 REMONUMENTATION PROGRAM
LAND CORNER RECORDATION CERTIFICATE
Filing Requirement of Act 74, Mich. P.A. 1970**

For corners in Tuscola Township

<u>Tuscola</u> <small>(County)</small>	Located In:	Corner Code #
1. Public Land Survey	T <u>11N</u> R <u>7E</u>	<u>M-6</u>
	T _____ R _____	_____
	T _____ R _____	_____
	T _____ R _____	_____
2. Property Controlling in Section	S _____ T _____ R _____	_____
	S _____ T _____ R _____	_____
3. Miscellaneous Property in Sec.	S _____ T _____ R _____	_____
	S _____ T _____ R _____	_____

RECEIVED FOR RECORD
LIBER NO. _____ PAGE NO. _____
FILING NO. # 75
TUSCOLA # TWP
95 OCT -5 PM 2:09
VIRGINIA H. McLAREN
TUSCOLA COUNTY
REGISTER OF DEEDS

Register of Deeds Stamp & File Number

4. Lot No. _____, Recorded Plat _____
5. Private Claims _____

A	B	C	D	E	F	G	H	I	J	K	L	M
2	6	5	4	3	2	1						
3												
4	7	8	9	10	11	12						
5												
6	13	17	16	15	14	13						
7												
8	19	20	21	22	23	24						
9												
10	30	29	28	27	26	25						
11												
12	31	32	33	34	35	36						
13												

I, Kenneth D. Dunton, in a field survey on June 18, 1995, do hereby certify that under requirements of P.A. 74, Michigan P.A. of 1970, the corner points mentioned in lines 1 and 2 above were in conformance with regulations and rules therefore as required in the current manual of survey instructions of the United States Department of the Interior, Bureau of Land Management or by a decree of a Court of Law and/or that the corner points mentioned in lines 3, 4 and 5 above were in conformance with the rules of the Michigan Board of Land Surveyors or by a Decree of a Court of Law; established, re-established, monumented, re-monumented, recovered, found as expressed below:

NOTE: Not more than 4 corners, all in the same town and range, may be recorded on this certificate.

A. Description of original monument and accessories and/or subsequent restoration:

1821 G.L.O. Notes Joseph Wampler, D. S. Set 1/4 Section Post Birch 8" S 36 1/2W 12 Ash 7" N 74E 9	Nov. 2, 1976 Act 74 form by K. D. Dunton, R.L.S. #23503 with Rowe Eng., Inc., fnd. boat spike. East 1.5' centerline asphalt, S65°E 254.45' R.L.S. tag in p.p., west 33.00' 1/2" re-rod, N45°W 26.00' 1/2" re-rod. Dec. 20, 1976 Survey by David T. Rowe, R.L.S. #11192, recorded in Liber 469 on Page 146 Tuscola Co. records. No mention of object found or set or accessories.
---	---

Section A continued on back of this form.

B. Description of corner evidence found and/or method applied in restoring or reestablishing corner:

Found boat spike in mon. box per data in Section A of this form. Also found 2" iron bar 26" below grade at approximate split of measured mile between corners M-5 to M-7, T11N-R7E. Held 2" iron bar as best evidence of corner M-6, T11N-R7E.

SURVEYOR
DEC 01 1995
COMMISSION

C. Description of monument for corner and accessories established to perpetuate locating the position of the corner:

24" long
Placed concrete monument with standard brass cap stamped corner M-6, T11N-R7E over 2" iron bar. Place monument box over monument.


- N48°12'W 106.90' fnd. spike & disk #37276 in S. face 12" pine.
- N39°34'W 50.91' fnd. 1/2" re-rod at back of west ditch bank.
- N40°31'E 51.23' set 1/2" re-rod at back of East ditch bank.
- N17°07'W 60.50' fnd. 1/2" re-rod in road shoulder.
- N00°27'E 39.10' fnd. boat spike in mon. box.
- N00°10'W 287.03' fnd. iron stake in mon. box at apparent corner A-6, T11N-R8E.

COPY

Signed by [Signature] Date 10-2-95
Surveyor's Michigan License No. 23503

APPROVED
10-2-95
[Signature]

FORM APPROVED BY MICHIGAN STATE BOARD OF LAND SURVEYORS, JAN. 23, 1971
REVISED MAY 31, 1975
REVISED JAN., 1983

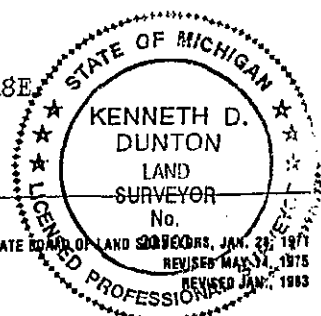

Section A continued:

Nov. 12, 1993 Survey by Jonathan M. Field, L.S. #37276 with Rowe Eng., Inc. recorded in Liber 655 on Pages 459 & 460 Tuscola Co. records. Fnd. boat spike in mon. box. N80°W 86.20' set nail w/tag #37276 in S. face 10" pine, S80°E 254.44' fnd. nail w/tag #11192 in W. face p. pole, North 247.98' top center mon. box, N05°W 142.91' center of sign post.

