1995 REMONUMENTATION PROGRAM LAND CORNER RECORDATION CERTIFICATE

		CORNER RECORDATION CERTIF	ICATE < 9 T C B.
_	Filing R	equirement of Act 74, Mich. P.A	RECEIVED LIBERNO. FILING NO FILING N
For corners in Tuscola	Township	1	SCC HELL
Tuscola (County)	Located In:	Corner Code =##	RC SAL FO
Public Land Survey	т <u>11N</u> в <u>'</u>	7E <u>M</u> –7	PA R R PH
	ŢR		ENTRY CALCUS
2. Property Controlling	S T R_		. 0
in Section	STR_		, ,
3. Miscellaneous	S T R _		Register of Deeds Stamp & File Number
Property in Sec.	S T R _		
			A B C D E F G H I J K L M
5. Private Claims			2 - 5 - 1 - 3 - 1 - 1 -
			3
TF 15 75 75		T. 18	4 7 8 9 10 11 12-
de hereby certify that under ret	, in a field survey on	June 17 , 19 95 an P.A. of 1970, the corner points mention	_ , 5
in lines 1 and 2 above were in	n conformance with regulat	ions and rules therefore as required in	the the
current manual of survey instr	uctions of the United States	Department of the Interior, Bureau of La e corner points mentioned in lines 3, 4 an	
above were in conformance wi	th the rules of the Michigan	Board of Land Surveyors or by a Decree of	ofa of the first transfer of transfer of the first transfer of t
Court of Law; established,	re-established, monumente	ed, re-monumented, recovered, found	as 10 30 - 29 - 28 - 27 - 26 - 25
expressed below:	ornare all in the came t	own and range, may be recorded	11
on this certificate.		om and lange, may be recovered.	12 31 32 33 34 35 36
A. Description of original	monument and accessor	ies and/or subsequent restoration:	13
1821 G. L. O. Note	n 10	950 Witness card, source u	nknown, set 1/2" iron pin approxi-
Joseph Wampler P.		tely according to notes I	.C.R.C., S50°W 46.4'-24" maple,
Set post corner to	N ⁴	60°W 84.7'-ρ.ρ.	
Sections 13 & 24.	Jı	me 24, 1971 survey by D.	T. Rowe, R.L.S. #11192, recorded in
Hemlock 8" S13E 2		ber 1 of Surveys on Page	157, Tuscola Co. records. 1/2"
Hemlock 10" N34W 1		EOM 11 001 10 1	aple, N55°W 62.94' nail in t.p.,
Section A continue	d on back of this	form. June 9, 1972 Su	rvey by D. T. Rowe, R.L.S. #11192,
		recorded in Lib	orner & accessories same as Liber
B. Description of corner e	vidence found and/or m	ethod applied in restoring or reestar	rvey by D. T. Rowe, R.L.S. #11192, er 2 of Surveys on Page 345, Tusco orner & accessories same as Liber 1 shing corner: Page 1
Found 1/2" re-rod	in monument box ar	nd accepted as the proper	position of the corner.
9.1. 9.1.	STATES &	•	
ye e e e e			
	•		<i>P</i> .
Üt	(C < 1995		1
O(C	MMISSION		
C. Description of monume	ent for corner and access	sories established to perpetuate loca	ating the position of the corner:
		orner M-7, TllN-R7E over 1	
re-rod and cap in	concrete in mon. 1	OOX.	- Mariana
S64°07'W 46.50' fn	d. spike & tag #37	7276 in N. face 24" maple.	
N63°11'W 85.51' fn	d. p.k. nail & tag	#37276 in S. face new p.	pore.
N53°13'W 62.95' 11	d. bottle cap & na d. n.k. nail & tac	ail in SE face t.p. stub. 37276 in NW face new p.	pole.
West 0 65! physical	1 centerline N-S :	oave.	
NO0°08'10"W 255.32	fnd. 1/2" re-roo	in mon. box at apparent	corner A-7, TllN-RSE of Mic.
		* * * * * * * * * * * * * * * * * * *	1 6 1 1 1 1 1 1 1 1 1 1 1 1 1 1 1 1 1 1
		7 7	KENNETH D.
11	1	X	10-2-95 * DUNTON :
Signed by	_ W.	Date	SURVEYOR &
Surveyor's Michigan Licens	se No. <u>23503</u>	APPROVED OFF	OBM APPROVED BY MICHIGAN STATE EXPED DE LAND SUBJECTORS, JAW. 20, 197
		10-2-95 gmg	AETISEO JAH. 1983
		9m4.	OVESSION TO

Aug. 7, 1974 Survey by D. T. Rowe, R.L.S. #11192 recorded in Liber 445 on Page 747, Tuscola County Records. 1/2" re-rod, N45°E 44.81' nail & cap in p.p., N60°W 84.43' nail & cap in p.p., N55°W 62.94' nail & cap in t.p.


Dec. 20, 1976 Survey by D. T. Rowe, R.L.S. #11192 recorded in Liber 469 on Page 146, Tuscola County Records. No mention of object found or set or accessories.

April 7, 1982 Survey by Richard R. Boldt, R.L.S. #28405 with Rowe Eng., Inc., recorded in Liber 525 on Page 79, Tuscola County Records. 1/2" re-rod. Accessories same as Liber 445, Page 747 with addition of West 0.65' centerline 20' asph. pave.

April 29,1986 Survey by Jack N. Cwens, L.S. #20709 with Rowe Eng., Inc., recorded in Liber 561 on Pages 1471-1473 Tuscola County Records. Fnd. 1/2" re-rod. S60°W 45.97' nail & cap 24" maple, S75°W 75.08' nail & cap 15" maple, N55°W 62.94' nail & cap t.p., West 0.7' C/L N-S pavement, S20°W 12.82' iron bar.

March 9, 1988 Survey by K. D. Dunton, R.L.S. #23503, recorded in Liber 582 on Page 960, Tuscola County Records. No mention of object found or set or accessories.

Aug. 24, 1990 Survey by Paul N. Brown, L.S. #33134, with Rowe Eng., Inc., recorded in Liber 606 on Page 609 Tuscola County Records. 1/2" re-rod. N45°E 44.88' nail & cap in p.p., N60°W 84.43' nail & cap in p.p. N55°W 62.94' nail & cap in t.p., S65°W 45.97' nail & cap in 24" maple.

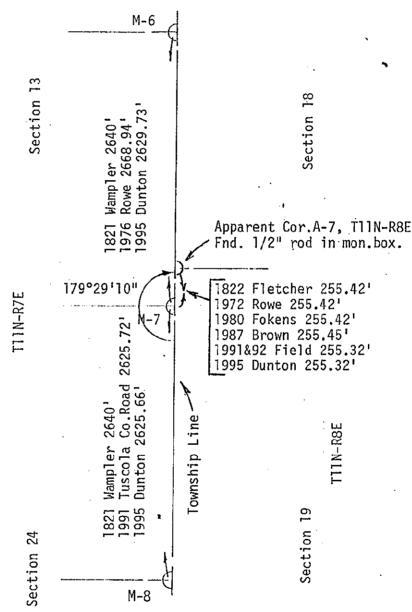

nie: Heist

DESCO B