

**SURVEY &  
REMONUMENTATION**

APR 25 1995

COMMISSION

**COPY**

1994 REMONUMENTATION PROGRAM  
**LAND CORNER RECORDATION CERTIFICATE**  
Filing Requirement of Act 74, Mich. P.A. 1970

For corners in Tuscola Township

Tuscola (County)	Located In:	Corner Code #
1. Public Land Survey	T <u>11N</u> R <u>7E</u>	<u>M-9</u>
	T _____ R _____	_____
	T _____ R _____	_____
	T _____ R _____	_____
2. Property Controlling in Section	S _____ T _____ R _____	_____
	S _____ T _____ R _____	_____
3. Miscellaneous Property in Sec.	S _____ T _____ R _____	_____
	S _____ T _____ R _____	_____

RECEIVED FOR RECORD  
LIBER NO. \_\_\_\_\_ PAGE NO. \_\_\_\_\_  
FILING NO. # 69  
TUSCOLA TWP  
94 DEC -7 PM 4: 25  
VIRGINIA M. McLAUREN  
TUSCOLA COUNTY  
REGISTER OF DEEDS

Register of Deeds Stamp & File Number

4. Lot No. \_\_\_\_\_, Recorded Plat \_\_\_\_\_  
5. Private Claims \_\_\_\_\_

	A	B	C	D	E	F	G	H	I	J	K	L	M
2	6	5	4	3	2								
3													
4	7	8	9	10	11	12							
5													
6	13	17	16	15	14	13							
7													
8	19	20	21	22	23	24							
9													
10	30	29	28	27	26	25							
11													
12	31	32	33	34	35	36							
13													

I, Kenneth D. Dunton, in a field survey on October 30, 19 94, do hereby certify that under requirements of P.A. 74, Michigan P.A. of 1970, the corner points mentioned in lines 1 and 2 above were in conformance with regulations and rules therefore as required in the current manual of survey instructions of the United States Department of the Interior, Bureau of Land Management or by a decree of a Court of Law and/or that the corner points mentioned in lines 3, 4 and 5 above were in conformance with the rules of the Michigan Board of Land Surveyors or by a Decree of a Court of Law; established, re-established, monumented, re-monumented, recovered, found as expressed below:

**NOTE: Not more than 4 corners, all in the same town and range, may be recorded on this certificate.**

**A. Description of original monument and accessories and/or subsequent restoration:**

1821 G.L.O. Notes	Dec. 19, 1977 Land Cor. Rec. Cert. filed on Page 39, Tuscola Twp.
Joseph Wampler, D.S.	by Kenneth D. Dunton, L. S. #23503 with Rowe Eng., Inc. Fnd. 2 1/2"
Set post corner to	pipe 12" deep. Raised with 1/2" pipe.
Secs. 24 & 25.	North 56.61' fnd. 1/2" iron rod at SW cor. Sec. 19, T11N-R8E.
Beech 10 S 8 W 16	N45°W 53.82' p. k. in p. pole.
Beech 5 N 18 E 8	S70°E 32.90' R.L.S. #11192 tag in 12" ash.
	N70°E 28.30' nail & flagging in 15" maple.

Sec. A continued on back of this form.


**B. Description of corner evidence found and/or method applied in restoring or reestablishing corner:**

Found 1/2" pipe in mon. box and accepted as the proper position of the corner.

**C. Description of monument for corner and accessories established to perpetuate locating the position of the corner:**

Placed standard brass cap stamped corner M-9, T11N-R7E over 1/2" pipe found in mon. box. Encased pipe and cap in concrete in mon. box.  
 N87°54'W 33.00' fnd. 1/2" rod & cap (cap not legible).  
 N55°53'W 53.80' fnd. p.k. nail in SW face p. pole. Set T. C. Remon. tag & spike above.  
 N71°51'E 28.27' fnd. #11192 tag & nail in W. face 24" maple, set T. C. Remon. tag & spike above.  
 S71°34'E 32.96' fnd. remains of nail - set T. C. Remon. tag & spike above.  
 S44°24'E 35.35' fnd. #11192 tag & spike in W. root of 42" maple.  
 N02°24'20"E 59.60' fnd. 1/2" rod in mon. box, apparent cor. A-9, T11N-R8E.

Signed by [Signature] Date \_\_\_\_\_  
 Surveyor's Michigan License No. 23503  
**APPROVED**  
12-05-94

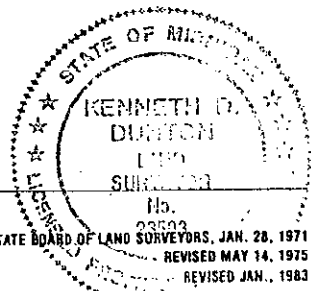

Section A continued:

Dec. 27, 1977 Survey by Kenneth D. Dunton, L.S. #23503 with Rowe Eng. Inc., recorded in Liber 485 on Pages 415 & 416 Tuscola County records. 1/2" pipe in 2 1/2" pipe. Accessories same as L.C.R.C. Page 39.

March 9, 1988 Survey by Kenneth D. Dunton, L.S. #23503, recorded in Liber 582 on Page 960, Tuscola County records. Fnd. 1/2" pipe in 2 1/2" pipe.

N02°E 59.61' 1/2" iron at closing corner near SW cor. Sec. 19, T11N-R8E.

N45°W 53.82' p.k. in p. pole.

N70°E 28.30' nail in 15" maple.

Dec. 19, 1988 Survey by Stephan J. Szyszkoski, L.S. #33986 with Rowe Eng. Inc., recorded in Liber 589 on Pages 336 & 337, Tuscola County records. Found 1/2" pipe in 2 1/2" pipe.

N02°E 56.61' 1/2" iron at closing corner near SW cor. Sec. 19, T11N-R8E.

N70°E 28.30' nail & flag in 20" maple.

N45°W 53.82' fnd. p.k. nail in p/p.

S40°E 35.36' set nail & tag #11192 W. root 36" maple.

July 29, 1992 Survey by Jonathan M. Field, L.S. #37276 with Rowe Eng. Inc., recorded in Liber 630 on Pages 802 & 803, Tuscola County records. Found 1/2" pipe in 2 1/2" pipe. Accessories same as Liber 589 on Pages 336 & 337.

June 7, 1993 Survey by Jonathan M. Field, L.S. #37276 with Rowe Eng. Inc., recorded in Liber 644 on Pages 311 & 312, Tuscola County records. Fnd. 1/2" pipe in mon. box. Accessories same as Liber 589, Pages 336 & 337 and Liber 630, Pages 802 & 803.

