## SURVEY & REMONUMENTATION



FEB 08 2001

SECTION

## 2000 REMONUMENTATION PROGRAM LAND CORNER RECORDATION CERTIFICATE Filing Requirement of Act 74,

R RECORDATION CERTIFICATE
Requirement of Act 74,
Mich. P.A. 1970

RECEIVED FOR RECORD

LIBER NO. PAGE NO.

TAF NO. # 122 Vassar


For corners in: VASSAR TW	Р.	the state of the s
Tuscola Located In:	Corner Code #	00 DEC 19 PH 1: 35
1. Public Land Survey	T <u>11N R 8E K-1</u> T R T R T R	TUSCOLA COURTY REGISTED OF TOS
2. Property Controlling	S R	
in Section	S R	
3. Miscellaneous	S R	Register of Deeds Stamp & File Number
Property in Sec.	S	

4.	Lot	No.		Recorded	Plat
			 ,		

5. Private Claims

I, <u>Kari M. Lohela</u>, in a field survey on <u>October 26</u>, 20 <u>00</u> do hereby state that under requirements of P.A. 74, Michigan P.A. of 1970, the corner points mentioned in lines 1 and 2 above were in conformance with regulations and rules therefore as required in the current manual of survey instructions of the United States Department of the Interior, Bureau of Land Management or by a decree of a Court of Law and /or that the corner points mentioned in lines 3, 4 and 5 above were in conformance with the rules of the Michigan Board of Land Surveyors or by a Decree of a Court of Law; established, re-established, monumented, recovered, found as expressed below:

NOTE: Not more than 2 corners, all in the same town and range, may be recorded on this certificate.

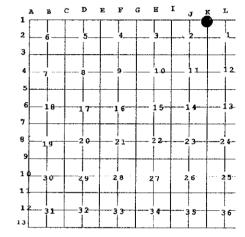

A. Description of original monument and accessories and/or subsequent restoration:

1822 G.L.O., JOSEPH FLETCHER, D.S., INT. N. BOUNDARY 33 LKS W. OF POST CORNER TO SECTIONS 35 & 36, SET POST AT INTERSECTION, BEECH 9 CORNER TREE

AUG. 3, 1983, SURVEY L.539 P.1497, RICHARD BOLDT, PS 28405, FOUND BOAT SPIKE IN MON. BOX, S60°W 54.80' SET NAIL W/TAG IN 4" ASH TREE IN CLUSTER, N45°W 45.00' CENTER OF ROAD SIGN POST, N40°E 82.94' SET NAIL W/TAG IN S. FACE OF P. P.

NOV. 14,1983, LCRC P.65 VASSAR TWP., RICHARD BOLDT, PS 28405, FOUND BOAT SPIKE IN MON. BOX, S60°W 54.80' SET NAIL W/TAG IN 4" ASH TREE IN CLUSTER, N45°W 45.00' CENTER OF ROAD SIGN POST, N40°E 82.94' SET NAIL W/TAG IN S. FACE OF P. P., S70°W 81.12' SET NAIL W/TAG N. FACE OF 10" PINE

B. Description of corner evidence found and/or method applied in restoring or reestablishing corner:

FOUND BOAT SPIKE IN MONUMENT BOX 0.24' NORTH OF STD. TOWNSHIP LINE. RECOVERED 2 ACCESSORIES WHICH INDICATE THAT BOAT SPIKE IS IN SAME POSITION AS SURVEY AND LCRC CITED ABOVE.

EXTENDED SECTION LINE SOUTHERLY, FROM FOUND BOAT SPIKE AND CORNER K-2, TO INTERSECTION WITH STD. TOWNSHIP LINE. SET AMENDED CORNER ON STD. TOWNSHIP LINE.

C. Description of monument for corner and accessories established to perpetuate locating the position of the corner:

REMOVED BOAT SPIKE AND PLACED STANDARD BRASS CAP STAMPED K-1 AC (AMENDED CORNER), T11N-R8E, ON 5/8" BAR. ENCASED CAP AND BAR IN CONCRETE IN NEW MONUMENT BOX. N40°E, 89.83' SET REMON. TAG & NAIL ABOVE FOUND NAIL & TAG IN SE FACE OF UTILITY POLE EAST, 21.55' FOUND TUSCOLA COUNTY MONUMENT STAMPED K-13, T12N, R8E S65°E, 69.58' SET REMON. TAG & NAIL ABOVE FOUND NAIL & TAG IN SW FACE OF UTILITY POLE N50°W, 44.79' FACE OF STEEL ROAD SIGN POST

FEB 08 2001

K-1 T11N-R8E

SECTION

Signed by

Date 12/18/00

APPROVED BY TUSCOLA COUNTY REMONUMENTATION PEER GROUP

MWP 121 /3 / 2000


Surveyor's Michigan License No. 442899

APPROVED BY MICHIGAN STATE BOARD OF PROFESSIONAL SURVEYORS, JAN. 28, 1971 REVISED MAY 14,1975

REVISED JAN., 1983 REVISED OCT., 1995

1400

KARI M. LOHELA PROFESSIONAL SURVEYOR NO. 44289 NOTE: 1995 MEASURMENTS BY FIELD ARE TO CORNER L-1, T11N, R8E; MONUMENT WAS CORRECTLY SET AT POSITION L-13, T12N, R8E. MARCH 2000, CONFIRMED BY DUNTON SURVEY FOR TUSCOLA COUNTY ROAD COMMISSION

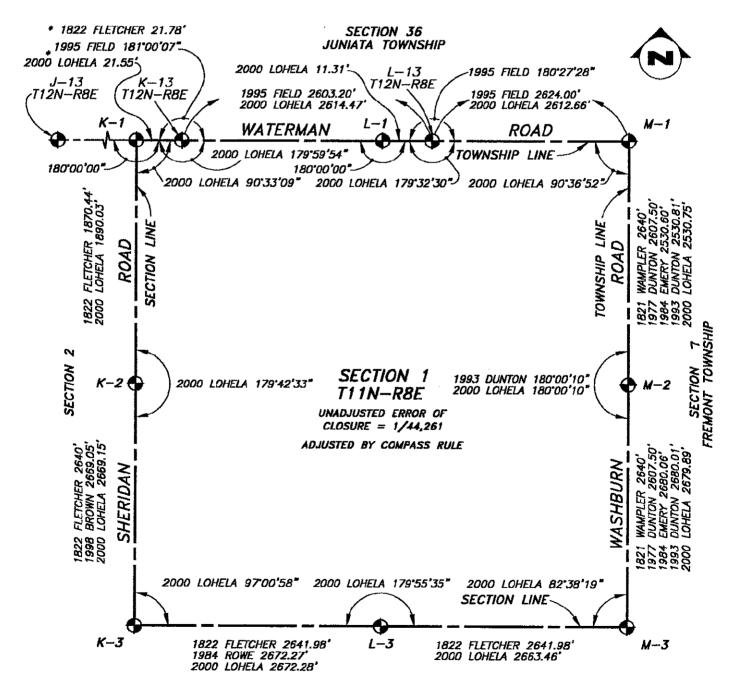

SECTION 12